

MAY 28 1997

COMMISSION

LAND CORNER RECORDATION CERTIFICATE
Filing Requirement of Act 74, Mich. P.A. 1970

STATE OF MICHIGAN
ROSCOMMON COUNTY
RECORDED

27 DEC 96 2:17 P.M.

ROBERT W. SMITH
REGISTER OF DEEDS

Register of Deeds Stamp & File Number

For corners in

ROSCOMMON
(County)

Located In:

Corner Code ##

1. Public Land Survey

T. 24 N R. 3 W

C-13

T. 23 N R. 3 W

C-1

T. _____ R. _____

T. _____ R. _____

2. Property Controlling
in Section

S. _____ T. _____ R. _____

S. _____ T. _____ R. _____

3. Miscellaneous
Property in Sec.

S. _____ T. _____ R. _____

S. _____ T. _____ R. _____

4. Lot No. _____, Recorded Plat _____

5. Private Claims _____

I, Frank J. Arleth, in a field survey on November 6, 19 96

do hereby certify that under requirements of P.A. 74, Michigan P.A. of 1970, the corner points mentioned in lines 1 and 2 above were in conformance with regulations and rules therefore as required in the current manual of survey instructions of the United States Department of the Interior, Bureau of Land Management or by a decree of a Court of Law and/or that the corner points mentioned in lines 3, 4 and 5 above were in conformance with the rules of the Michigan Board of Land Surveyors or by a Decree of a Court of Law; established, re-established, monumented, re-monumented, recovered, found as expressed below:

NOTE: Not more than 4 corners, all in the same town and range, may be recorded on this certificate.

A. Description of original monument and accessories and/or subsequent restoration:

WILLIAM BURT 1852

W. PINE 18" N22½°E, 39 LKS.

Y. PINE 12" N46°W, 35 LKS.

Y. PINE 16" S45°W, 42 LKS.

W. PINE 30" S70°E, 22 LKS.

DELAMATER 1924 FOUND B.T.S. & POST

WIT. 18" W. PINE STP. N22°E, 25.70'

WIT. 24" W. PINE STP. S70°E, 31.30'

WIT. 30" W. PINE STP. S40°E, 19.80'

WIT. 24" W. PINE STP. S68°W, 22.40'

HENNING 1947 FOUND AND USED B.T.S. OK.
IRON IN CORNER

HENNING 1955 IN ROAD SURVEY

FOUND 1/2" BAR IN CORNER

MKD. 8" B. OAK S53°E, 74.5'

MKD. 10" B. OAK S58½°W, 80.5'

MKD. 10" W. OAK N18°E, 76.20'

ROSCOMMON Co. RD. COMM.

FOUND IN PAV'T. BOX

CENTERLINE OF Co. RD. 104

PLAT OF HIGGINS LAKE

B. Description of corner evidence found and/or method applied in restoring or reestablishing corner: HIGHLANDS L- 5, P-77

FOUND 1/2" BAR IN PAV'T. BOX, CENTERLINE OF Co. RD. #104 AND ROADS N&S.

FOUND OLD WIT. 8" B. OAK S53°E, 74.50'

FOUND OLD WIT. 10" S58½°W, 80.50'

ROSCOMMON COUNTY

PEER GROUP APPROVAL

DATE Nov 8th 1996

Marvin E. Myers

Marvin E. Myers, P.S.
County Surveyor

C. Description of monument for corner and accessories established to perpetuate locating the position of the corner:

1/2" BAR IN PAV'T. BOX WITH CAP # 21266 IN CENTERLINE OF Co. RD. #104 AND ROADS N&S.


N & T POWER POLE N46°E, 41.05'

N & T 16" W. PINE S50°W, 94.95'

N & T 5" MAPLE N46°W, 72.45'

N & T B. OAK S46°W, 60.78'

SET CARSONITE POST N45 E, 45.95'

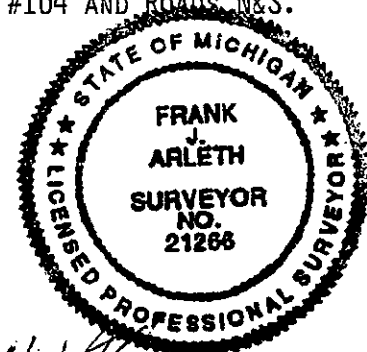

Signed by

Date

Surveyor's Michigan License No. 21266, P.S.

FORM APPROVED BY MICHIGAN STATE BOARD OF LAND SURVEYORS, JAN. 28, 1971
REVISED MAY 14, 1975
REVISED JAN., 1983

DATE:

PEER GROUP APPROVAL

LIBER 3 PAGE 390