

5085

JAN 24 1996

LAND CORNER RECORDATION CERTIFICATE
Filing Requirement of Act 74, Mich. P.A. 1970

For corners in
Roscommon
(County)

Located In:

Corner Code #

STATE OF MICHIGAN
ROSCOMMON COUNTY
RECORDED

14 AUG 95 3:47 P.M.

ROBERT W. SMITH
REGISTER OF DEEDS

1. Public Land Survey T 24N R 4W G - 8
T R
T R
T R
2. Property Controlling S T R
in Section S T R
3. Miscellaneous S T R
Property in Section S T R

APR 05 1996

To be filed in Liber 3 of Land Corner

Register of Deeds Stamp & File Number

4. Lot No. , Recorded Plat
5. Private Claims

I, Marvin E. Myers, in a field survey on July 25, 1995, do hereby certify that under requirements of P.A. 74, Michigan P.A. of 1970, the corner points mentioned in lines 1 and 2 above were in conformance with regulations and rules therefore as required in the current manual of survey instructions of the United States Department of the Interior, Bureau of Land Management or by a decree of a Court of Law and/or that the corner points mentioned in lines 3, 4 and 5 above were in conformance with the rules of the Michigan Board of Professional Surveyors or by a Decree of a Court of Law; established, re-established, monumented, re-monumented, recovered, found as expressed below:

NOTE: Not more than 4 corners, all in the same town and range, may be recorded on this certificate.

A. Description of original monument and accessories and/or subsequent restoration:

GLO-A. Brewer Aug. 1852 G.D. Henning Oct. 1948
Mon-Post Mon-1/2" x 24" Bar
WIT: 8" Maple N60°E 25 lks. WIT: 7" W.Oak N63°W 26.40'
8" W.Oak S38°W 39 lks. 8" Oak N73°E 57.30'
Set by single proportion

B. Description of corner evidence found and/or method applied in restoring or reestablishing corner:


Found 1/2" x 18" Pipe verified position by measurement to corner North and South.

ROSCOMMON COUNTY
PEER GROUP APPROVAL
DATE AUG 8th 1995

Marvin E. Myers
Marvin E. Myers, P.S.
County Surveyor

C. Description of monument for corner and accessories established to perpetuate locating the position of the corner:

Mon-Set Std. Roscommon County Monument
WIT: Nail & Tag SE face 6" Poplar S62°W 45.25'
Nail & Tag S. face of South Gate Post S72°E 41.62'
Fd. spike N. side Power Pole N73°E 34.14'
Fd. spike N. side Guy Pole N57°W 34.00'
Set Nail & Tag NE face 5" Maple N38°W 57.77'

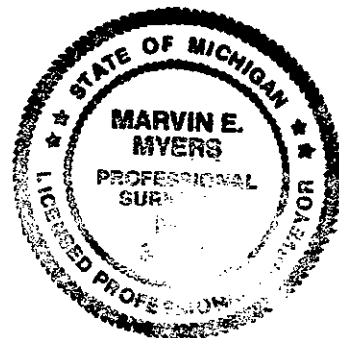

Signed by Marvin E. Myers

Date AUG 9th 1995

Surveyor's Michigan License No. 31600

FORM APPROVED BY MICHIGAN STATE BOARD OF PROFESSIONAL SURVEYORS, JAN. 28, 1971
REVISED MAY 14, 1975
REVISED JAN., 1983