

SURVEY & REMONUMENTATION

NOV 12 1993

LIBER 1883 PAGE 28

Liber 6 Page 135

COMMISSION

LAND CORNER RECORDATION CERTIFICATE Filing Requirement of Act 74, Mich. P.A. 1970

RECORDED + FILED

For corners in

Saginaw

(County)

Located In:

Corner Code =#

1. Public Land Survey

T 12N R 4E

K-5

T 12N R 4E

L-1

T R

T R

2. Property Controlling
in Section

S T R

S T R

3. Miscellaneous
Property in Sec.

S T R

S T R

4. Lot No. , Recorded Plat

5. Private Claims

Nov 5 9 11 AM '93

REGISTER OF DEEDS
SAGINAW COUNTY MICH.

Register of Deeds Stamp & File Number

I, Brian D Ferguson, in a field survey on September 30, 19 93

do hereby certify that under requirements of P.A. 74, Michigan P.A. of 1970, the corner points mentioned in lines 1 and 2 above were in conformance with regulations and rules therefore as required in the current manual of survey instructions of the United States Department of the Interior, Bureau of Land Management or by a decree of a Court of Law and/or that the corner points mentioned in lines 3, 4 and 5 above were in conformance with the rules of the Michigan Board of Land Surveyors or by a Decree of a Court of Law; established, re-established, monumented, re-monumented, recovered, found as expressed below:

NOTE: Not more than 4 corners, all in the same town and range, may be recorded on this certificate.

A. Description of original monument and accessories and/or subsequent restoration:

K-5 Wood Post set by J. Wampler in 1822.
No evidence of original post exists.

L-1 No corner was set at time of original survey in 1822

B. Description of corner evidence found and/or method applied in restoring or reestablishing corner:

K-5 Found 3/4" pipe in monument box. Previous LCRC in L 3 Pg 51. One recorded survey is tied to this corner. One recorded subdivision is tied to this corner and is accepted as the best available evidence of the position of the original corner. Accepted by the Peer Review Group on 10/07/93

L-1 Found 3/4" solid rod in monument box. Previous LCRC's recorded in L 3 Pg 32 and L 3 Pg 105. One recorded survey is tied to this corner. One recorded subdivision is tied to this corner and is accepted as the best available evidence of the position of the original corner. Accepted by the Peer Review Group on 10/07/93

C. Description of monument for corner and accessories established to perpetuate locating the position of the corner:

K-5 3" Brass Disk in monument box

L-1 3" Brass Disk in monument box


N10°E 40.40' Chisled + S fce W'ly pier NB I-675
N20°W 32.87' Nail & tag S fce pwr pole
S20°W 41.27' Chisled + N fce E'ly Pier SB I-675
S30°E 55.06' Chisled + N fce W'ly Pier NB I-675

N50°W 83.22' Top ctr hydrant
N40°E 64.21' Nail & Tag in SE fce pwr pole
S45°E 53.16' Nail & Tag in W fce pwr pole
S45°W 49.44' Nail & Tag in NW fce pwr pole

Signed by

Surveyor's Michigan License No.

Date

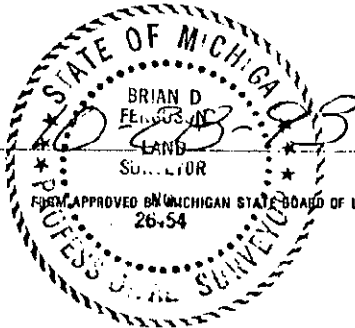

REVISED MAY 14, 1975
REVISED JAN., 1983

11/18/93