

SAGINAW COUNTY REMONUMENTATION

RECORDED/FILED

LAND CORNER RECORDATION CERTIFICATE
Filing Requirement of Act 74, Mich. P.A. 1970

1999 SEP 29 A 8:08

MILDRED M. DODAK
REGISTER OF DEEDS
SAGINAW COUNTY, MI.

For corners in

KOCHVILLE TOWNSHIP

SAGINAW
(County)

Located in:

Corner Code #

1. Public Land Survey T13 N R 4 E L-11
T R
2. Property Controlling S T R
In Section S T R
3. Miscellaneous S T R
Property in Sec. S T R

LIBER 2144 PAGE 781

Lib 8 Page 76

Register of Deeds Stamp & File Number

4. Lot No. Recorded Plat
5. Private Claims

I, Brian D Ferguson, in a field survey on JUNE 26, 19 99 do hereby state that under requirements of P.A. 74, Michigan P.A. of 1970, the corner points mentioned in lines 1 and 2 above were in conformance with regulations and rules therefore as required in the current manual of survey instructions of the United States Department of the Interior, Bureau of Land Management or by a decree of a Court of Law and/or that the corner points mentioned in lines 3, 4 and 5 above were in conformance with the rules of the Michigan Board of Land Surveyors or by a Decree of a Court of Law; established, re-established, monumented, recovered, found as expressed below:

NOTE: Not more than 2 corners, all in the same town and range, may be recorded on this certificate.

	A	B	C	D	E	F	G	H	I	J	K	L	M
1													
2	6			5		4		3		2		1	
3													
4	7			8		9		10		11		12	
5													
6	18			17		16		15		14		13	
7													
8	19			20		21		22		23		24	
9													
10	30			29		28		27		26		25	
11													
12	31			32		33		34		35		36	
13													

A. Description of original monument and accessories and/or subsequent restoration:

WOOD POST SET BY J. WAMPLER IN 1822, NO EVIDENCE OF ORIGINAL CORNER REMAINS
LCRC BY ROBERT TOMMER IN 1976, L 3, PG 170
LCRC BY JOHN MARTIN IN 1976, L 3, PG 239
RECORDED SURVEY IN L 1646, PG 1632

SURVEY &
RE

SEP 29 2000


SECTION

B. Description of corner evidence found and/or method applied in restoring or reestablishing corner:

FOUND 3/4" PIPE IN MONUMENT BOX PER LCRC BY TOMMER. VERIFIED LOCATION BY DISTANCES TO ADJOINING CORNERS FROM RECORDED AND UN-RECORDED SURVEYS.

C. Description of monument for corner and accessories established to perpetuate locating the position of the corner:

ACCEPTED BY PEER GROUP AS THE BEST AVAILABLE EVIDENCE OF THE POSITION OF THE ORIGINAL CORNER
SET 5/8" REBAR W/ 3" BRASS CAP IN MONUMENT BOX
S40W 77.60' MAG NAIL E FCE PWR POLE
S30E 71.00' NAIL & TAG NE FCE PWR POLE
N45E 48.60' NAIL & TAG S FCE PWR POLE
N50W 45.77' NAIL & TAG SW FCE PWR POLE

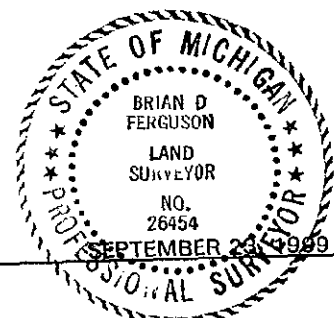

Signed by Brian D Ferguson
Surveyor's Michigan License No. 26454

Date _____