

REMONUMENTATION

LIBER 2 PAGE 6

RECEIVED FOR RECORD

94 DEC 16 AM 9:40

LAND CORNER RECORDATION CERTIFICATE

Filing Requirement of Act 74, Mich. P.A. 1970

For corners in Sanilac (County)

SURVEY & REMONUMENTATION COMMISSION APR 10 1995

LIBER NO. 2 PAGE NO. 6 ESTHER LEE REGISTER OF DEEDS SANILAC CO., MICHIGAN

Table with columns for survey type (Public Land Survey, Property Controlling in Section, Miscellaneous Property in Sec.), corner codes (S, T, R), and a specific corner code (G-13).

Register of Deeds Stamp & File Number

4. Lot No. , Recorded Plat
5. Private Claims

I, John A Milletics in a field survey on April 28, 1994, do hereby certify that under requirements of P.A. 74, Michigan P.A. of 1970, the corner points mentioned in lines 1 and 2 above were in conformance with regulations and rules therefore as required in the current manual of survey instructions of the United States Department of the Interior, Bureau of Land Management or by a decree of a Court of Law and/or that the corner points mentioned in lines 3, 4 and 5 above were in conformance with the rules of the Michigan Board of Land Surveyors or by a Decree of a Court of Law; established, re-established, monumented, re-monumented, recovered, found as expressed below:

Grid table with columns A-M and rows 2-13, containing numbers 1-36.


NOTE: Not more than 4 corners, all in the same town and range, may be recorded on this certificate.

Approved Peer Board Meeting Dec. 16, 1994

A. Description of original monument and accessories and/or subsequent restoration: G - 13 GLO Notes Set Post Elm 11 N 79 W 7, Elm 9 N29 1/2 E 35 Act 74 Forms None Act 132 Forms Liber 1 Page 283, Liber 3 Page 88 Road Comm None Drain Comm None

B. Description of corner evidence found and/or method applied in restoring or reestablishing corner: G - 13 SE Cor Section 33 T10N-R13E Found 1/2" Iron Bar

C. Description of monument for corner and accessories established to perpetuate locating the position of the corner: G - 13 SE Cor Section 33 T10N-R13E Found 1/2" Iron Bar East 25.27' to a 1/2" iron bar in road bed (NE of Section 4) N45°W 46.70' to a nail NE side of a Anchor Pole N45°E 46.90' to a nail NW side of a Power Pole S45°E 47.63' to a nail in the West side of a Anchor Polr

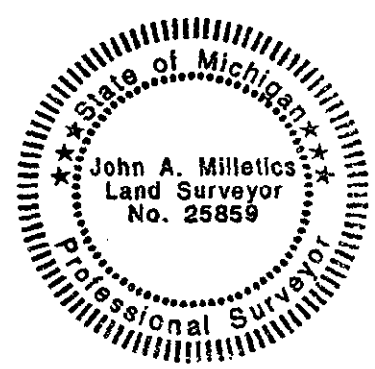

Signed by [Signature] Date Dec. 5, 1994 Surveyor's Michigan License No. 25859