

JAN 22 2001

LIBER 3 PAGE 43

RECEIVED FOR RECORD

00 NOV 27 AM 8:56

SECTION

2000 Remonumentation Program  
LAND CORNER RECORDATION CERTIFICATE  
Filing Requirement of Act 74, Mich. P.A. 1970

LIBER NO. 3 PAGE NO. 43  
MICHELE VANNORMAN  
REGISTER OF DEEDS  
SANILAC CO., MICHIGAN

For corners in

<u>Sanilac</u> (County)	Located in:	Corner Code #
1. Public Land Survey	T12N R16E	C - 7
	T R	
	T R	
	T R	
2. Property Controlling in Section	S T R	
	S T R	
3. Miscellaneous Property in Sec.	S T R	
	S T R	

Register of Deeds Stamp & File Number

4. Lot No. \_\_\_\_\_, Recorded Plat \_\_\_\_\_  
5. Private Claims \_\_\_\_\_

2000

I, John A Millettics, in a field survey on May 1, 2000 do hereby state that under requirements of P.A. 74, Michigan P.A. of 1970, the corner points mentioned in lines 1 and 2 above were in conformance with regulations and rules therefore as required in the current manual of survey instructions of the United States Department of the Interior, Bureau of Land Management or by a decree of a Court of Law and/or that the corner points mentioned in lines 3, 4 and 5 above were in conformance with the rules of the Michigan Board of Land Surveyors or by a Decree of a Court of Law; established, re-established, monumented, recovered, found as expressed below.

NOTE: Not more than 2 corners, all in the same town and range, may be recorded on this certificate.

1	A	B	C	D	E	F	G	H	I	J	K	L	M
2		6		5		4		3		2		1	
3													
4		7		8		9		10		11		12	
5													
6		18		17		16		15		14		13	
7													
8		19		20		21		22		23		24	
9													
10		30		29		28		27		26		25	
11													
12		31		32		33		34		35		36	
13													

A. Description of original monument and accessories and/or subsequent restoration:

GLO Notes

Beech 9" N76°W 9 Links

Beech 10" S25°E 7 Links

Act 132 - Irvin Chope Liber 1 Page 203, Irvin Chope Liber 2 Page 568

Sanilac Land Survey Liber 4 Page 261, Northwest Surveying Liber 4 Page 627

Sanilac Land Survey Liber 4 Page 99 . Sanilac Land Survey Liber 4 Page 625

L.C.R.C. - None

B. Description of corner evidence found and/or method applied in restoring or reestablishing corner:

C - 7


SW Corner Section 17 T12N-R16E

Found 1/2" Iron Bar 1' Below gravel road bed

West 2606.82 feet to the S 1/4 Corner

East 2674.06 feet to the S 1/4 Cor

Accepted as best evidence

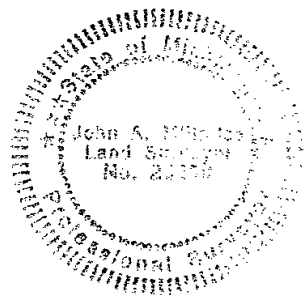

C. Description of monument for corner and accessories established to perpetuate locating the position of the corner:

C - 7

SW Corner Section 17 T12N-R16E

1/2" Iron Bar in Gravel Road Bed with Cap

South 3.50 feet to the centerline of gravel road bed

n20°W 35.00 feet to a Stop Sign

N30°W 51.45 feet to the SE Corner of a Riser Box

N45°W 61.83 feet to a nail in a 12" Maple

S30°E 48.00 feet to a Stop Sign

S50°E 50.95 feet to a nail in a 6" Pine

West 2606.82 feet to the S 1/4 Cor, East 2674.06 feet to the S 1/4 Cor.

APPROVED PEER BOARD  
MEETING NOV 25 2000

*gm*

Signed by John A Millettics

Date June 4, 2000

Surveyor's Michigan License No. 25859