

SURVEY & REMONUMENTATION

APR 14 1998

LIBER

2 PAGE 152

1997 REMONUMENTATION

LAND CORNER RECORDATION CERTIFICATE  
Filing Requirement of Act 74, Mich. P.A. 1970

RECEIVED FOR RECORD

97 DEC -2 AM 9:08

LIBER NO. 2, PAGE NO. 152  
ESTHER LEE  
REGISTER OF DEEDS  
SANILAC CO. MICHIGAN

SECTION

For corners in ARGYLE TOWNSHIP

SANILAC

(County)

Located In:

Corner Code #

1. Public Land Survey

T13N R13E

T13N R13E

T R

T R

C5  
B5

2. Property Controlling in Section

S

T R

S

T R

3. Miscellaneous Property in Sec.

S

T R

S

T R

SURVEY & REMONUMENTATION

JAN 08 1998

Register of Deeds & File Number

4. Lot No. , Recorded Plat

5. Private Claims

I, John A. Milletics, in a field survey on Oct. 25 19 97 do hereby state that under requirements of P.A. 74, Michigan P.A. of 1970, the corner points mentioned in lines 1 and 2 above were in conformance with regulations and rules therefore as required in the current manual of survey instructions of the United States Department of the Interior, Bureau of Land Management or by a decree of a Court of Law and/or that the corner points mentioned in lines 3, 4 and 5 above were in conformance with the rules of the Michigan Board of Land Surveyors or by a Decree of a Court of Law; established, re-established, monumented, recovered, found as expressed below:

NOTE: Not more than 2 corners, all in the same town and range, may be recorded on this certificate.

	A	B	C	D	E	F	G	H	I	J	K	L	M
1													
2		6		5		4		3		2		1	
3													
4		7		8		9		10		11		12	
5													
6		18		17		16		15		14		13	
7													
8		19		20		21		22		23		24	
9													
10		30		29		28		27		26		25	
11													
12		31		32		33		34		35		36	
13													

A. Description of original monument and accessories and/or subsequent restoration:

C5  
G.L.O. Notes Set Post Corner Sec's. 7, 8, 17 & 18  
Elm 12 S37E 19, Hemlock 14 N37W 24  
Act 74 Form - None  
Act 132 Form - L 3, Page 442  
Road Commission Record - None  
Drain Commission Record - None  
Unrecorded Survey - Huron Surveying  
August 7, 1997

B5  
G.L.O. Notes Set quarter Section Post  
Hemlock 9 N151/2W 10, Hemlock 14 S32E 17  
Act 74 Form - None  
Act 132 Form - L 3, Page 442 and  
L2, Page 266  
Road Commission Record - None  
Drain Commission Record - None


B. Description of corner evidence found and/or method applied in restoring or reestablishing corner:

C5

Found 5/8" Re-Rod in Monument Box

B5

Found 3/4" Re-Rod in Monument Box

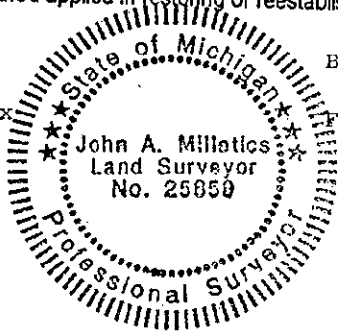

C. Description of monument for corner and accessories established to perpetuate locating the position of the corner:

C5  
Corner Sections 7, 8, 17, & 18, T13N-R13E  
Found 5/8" Re-Rod in Monument Box  
WITNESSES:  
N40°E 57.25' to 1/2" Steel Stake  
N45°W 56.55' to 1/2" Steel Stake  
S25°W 92.0' to Spike S.W. Side 12" Oak  
S50°E 70.95' to P.K. Nail in S.W. Side P.P.  
East 2635.15' to D5, T13N-R13E  
West 2613.95' to B5, T13N-R13E

B5  
1/4 Corner Sections 7 & 18, T13N-R13E  
Found 3/4" Re-Rod in Monument Box  
WITNESSES:  
N45°E 31.41' to 1/2" Steel Stake  
S45°E 32.10' to 1/2" Steel Stake  
S45°W 31.16' to 1/2" Steel Stake  
N45°W 31.71' to 1/2" Steel Stake  
East 2613.95' to C5, T13N-R13E  
West 2616.57' to A5, T13N-R13E

Signed by John A. Milletics

Surveyor's Michigan License No. 25859

Date Nov 12, 1997

PEER GROUP APPROVED

AT MEETING HELD

NOV. 26 1997