

RECEIVED
ST. CLAIR COUNTY

SEP 20 PM 2:20

RECORDS OF DEEDS
ST. CLAIR COUNTY

ST. CLAIR COUNTY, MICHIGAN
OFFICIAL GOVERNMENT CORNER



LAND CORNER RECORDATION CERTIFICATE
Filing Requirement of Act 74, Mich. P.A. 1970

Located In:

Corner Code ##

1. Public Land Survey

T 6N R 13E

F-1

2. Property Controlling
in Section

S T R

3. Miscellaneous
Property in Sec.

S T R

Seg. #1

Register of Deeds Stamp & File Number

4. Lot No. _____, Recorded Plat _____

5. Private Claims _____

Michael J. Rossow

May 2, 94

I, _____, in a field survey on _____, 19_____, do hereby certify that under requirements of P.A. 74, Michigan P.A. of 1970, the corner points mentioned in lines 1 and 2 above were in conformance with regulations and rules therefore as required in the current manual of survey instructions of the United States Department of the Interior, Bureau of Land Management or by a decree of a Court of Law and/or that the corner points mentioned in lines 3, 4 and 5 above were in conformance with the rules of the Michigan Board of Land Surveyors or by a Decree of a Court of Law; established, re-established, monumented, re-monumented, recovered, found as expressed below:

NOTE: Not more than 1 corner, may be recorded on this certificate.

A. Description of original monument and accessories and/or subsequent restoration:

No corner set in original Government Survey.

STATE PLAIN COORDINATES

St. Clair Co. Surveyors Record Lists nothing for this corner.

N. _____

Act 74 Cert. filed L.3,P.216 list a "3/4" Square Spike" as corner
L.5,P.44 lists a "3/4" Bar"

E. _____

ELEVATION _____

B. Description of corner evidence found and/or method applied in restoring or reestablishing corner:

Found 3/4" Square Road per Cert. filed L.3,P.216, "P.K. nail in 48" Oak
NE 319.50'", and L.5,P.44 "on FE. line S".

This corner also referenced on Act 132 Cert. filed L.9,P.321, all witnesses intact from this instrument.

C. Description of monument for corner and accessories established to perpetuate locating the position of the corner:

3/4" Square Rod. (1.64' North of a line between section corners.
S $\frac{1}{4}$ 33, SE 33, T.7N., R.13E.)

76.03' S to set P.K. in County Tag in 18" Elm.

318.51' ENE to set P.K. in County Tag in 42" Oak.

250.55' NW to set P.K. in County Tag in 10" Elm.

458.46' ESE to set P.K. in County Tag in 12" Poplar.

SEE ATTACHED SKETCH FOR ADDITIONAL INFORMATION.

Signed by


Michael J. Rossow

Date

May 13, 1994.

Surveyor's Michigan License No.

24615

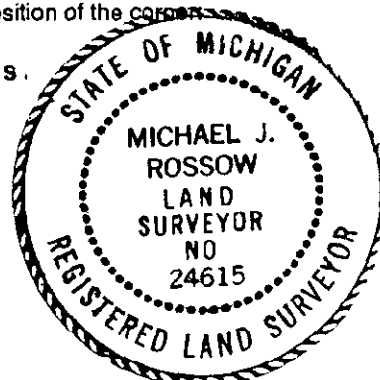

PA 345-1990

PEER COMMITTEE

APPROVED 6-17-94

APPROVED AS AN OFFICIAL GOVERNMENT CORNER BY ST. CLAIR COUNTY:

Signed By: _____

St. Clair County Land Surveyor

Surveyor's Michigan License No. _____

LIBER 007 PAGE 267

