

ST. CLAIR COUNTY, MICHIGAN
OFFICIAL GOVERNMENT CORNER



LAND CORNER RECORDATION CERTIFICATE
Filing Requirement of Act 74, Mich. P.A. 1970

	Located In:	Corner Code #
	Berlin Twp.	
1. Public Land Survey	6N 13E	J-1
	T R	
	T R	
	T R	
	T R	
2. Property Controlling	S T R	Seg #2
in Section	S T R	
3. Miscellaneous	S T R	
Property in Sec.	S T R	

RECEIVED
ST. CLAIR COUNTY
1995 FEB -4 AM 10:11
Register of Deeds Stamp & File Number

4. Lot No. _____, Recorded Plat _____
5. Private Claims _____

I, Daniel E. Johnson February 7, 1995
do hereby certify that under requirements of P.A. 74, Michigan P.A. of 1970, the corner points mentioned in lines 1 and 2 above were in conformance with regulations and rules therefore as required in the current manual of survey instructions of the United States Department of the Interior, Bureau of Land Management or by a decree of a Court of Law and/or that the corner points mentioned in lines 3, 4 and 5 above were in conformance with the rules of the Michigan Board of Land Surveyors or by a Decree of a Court of Law; established, re-established, monumented, re-monumented, recovered, found as expressed below:

NOTE: Not more than 1 corner, may be recorded on this certificate.

	A	B	C	D	E	F	G	H	I	J	K	L	M
2	6		5		4		3		2		1		
3													
4	7		8		9		10		11		12		
5													
6	18		17		16		15		14		13		
7													
8	19		20		21		22		23		24		
9													
10	30		29		28		27		26		25		
11													
12	31		32		33		34		35		36		
13													

- A. Description of original monument and accessories and/or subsequent restoration:


LIBER 007 PAGE 259

STATE PLAIN COORDINATES

N. _____
E. _____

- B. Description of corner evidence found and/or method applied in restoring or reestablishing corner:

LIBER 007 PAGE 259

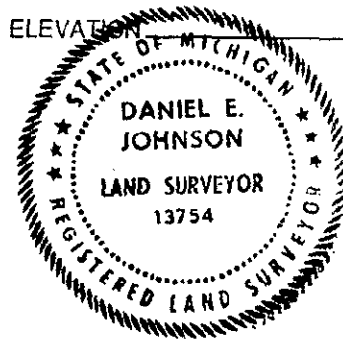

- C. Description of monument for corner and accessories established to perpetuate locating the position of the corner:

Set 1/2" x 18" Rebar with 2" dia. aluminum cap inscribed "St. Clair County Official Corner" with magnet.

(0.92' North of a line between section corners.
S $\frac{1}{4}$ 35, SE 36, T.7N., R.13E.)

78.41' NE to set P.K. and County Tag in Underground Tele Support Post.
Above MDSH Tag.

55.55' SE to set P.K. and County Tag in 8" Poplar.

177.26' NW to set P.K. and County Tag in P.Pole (Above Lg. Sp.).

421.67' N to set P.K. and County Tag in 42" Oak.

Signed by Daniel E. Johnson Date February 7, 1995
Daniel E. Johnson

Surveyor's Michigan License No. 13754

PA 345-1990
PEER COMMITTEE

APPROVED 6-17-94 John

APPROVED AS AN OFFICIAL GOVERNMENT CORNER BY ST. CLAIR COUNTY:

Signed By: Daniel E. Johnson : July 25, 1995
St. Clair County Land Surveyor Daniel E. Johnson
13754

Date

LIBER 002 PAGE 70