

ST. CLAIR COUNTY, MICHIGAN
OFFICIAL GOVERNMENT CORNER



LAND CORNER RECORDATION CERTIFICATE
Filing Requirement of Act 74, Mich. P.A. 1970

Located In: Berlin Twp. Corner Code ##
6N 13E L-1

1. Public Land Survey T R
T R
T R
T R

2. Property Controlling S T R
in Section S T R

3. Miscellaneous S T R
Property in Sec. S T R

Seg. # 2

RECEIVED
1995 AUG -4 AM 10:11
REGISTER OF DEEDS
ST. CLAIR COUNTY
REGISTERED

Register of Deeds Stamp & File Number

4. Lot No. _____, Recorded Plat _____
5. Private Claims _____

I, Daniel E. Johnson February 7, 1995
do hereby certify that under requirements of P.A. 74, Michigan P.A. of 1970, the corner points mentioned in lines 1 and 2 above were in conformance with regulations and rules therefore as required in the current manual of survey instructions of the United States Department of the Interior, Bureau of Land Management or by a decree of a Court of Law and/or that the corner points mentioned in lines 3, 4 and 5 above were in conformance with the rules of the Michigan Board of Land Surveyors or by a Decree of a Court of Law; established, re-established, monumented, re-monumented, recovered, found as expressed below:

NOTE: Not more than 1 corner, may be recorded on this certificate.

A. Description of original monument and accessories and/or subsequent restoration:

LIBER 007 PAGE 255

STATE PLAIN COORDINATES


N. _____

E. _____

ELEVATION _____

B. Description of corner evidence found and/or method applied in restoring or reestablishing corner:

LIBER 007 PAGE 255

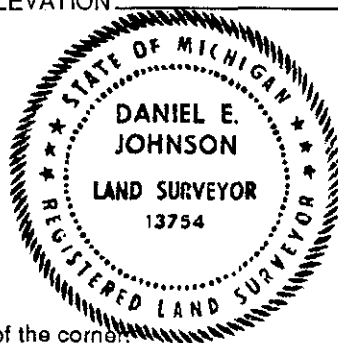

C. Description of monument for corner and accessories established to perpetuate locating the position of the corner:

Set 2" dia. aluminum cap inscribed "St. Clair County Official Corner" with magnet *on a*
5/8" Rod. (0.39' North to line between section corners, S 1/4 36, SE 36, T. 7N., R. 13E.)

138.70' WNW to set P.K. and County Tag in P. Pole.
201.80' ENE to set P.K. and County Tag in P. Pole.
413.07' ESE to set P.K. and County Tag W. most Guard Rail Post S. Side Burt Rd.
1372.70' S to set P.K. and County Tag in 42" Oak.

Signed by Daniel E. Johnson
Daniel E. Johnson
Surveyor's Michigan License No. 13754

Date February 7, 1995

PA 345-1990
PEER COMMITTEE *Dave*

APPROVED 6-17-94

APPROVED AS AN OFFICIAL GOVERNMENT CORNER BY ST. CLAIR COUNTY:

Signed By: Daniel E. Johnson
St. Clair County Land Surveyor Daniel E. Johnson
Surveyor's Michigan License No. 13754

July 25, 1995

LIBER 008 PAGE 68