

ST. CLAIR COUNTY, MICHIGAN
OFFICIAL GOVERNMENT CORNER

LAND CORNER RECORDATION CERTIFICATE
Filing Requirement of Act 74, Mich. P.A. 1970



RECEIVED
ST. CLAIR COUNTY
1995 AUG -4 AM 10:25

Located In: Corner Code #

1. Public Land Survey T 6N. R 15E. M-6
T _____ R _____
T _____ R _____
T _____ R _____
2. Property Controlling S _____ T _____ R _____
in Section S _____ T _____ R _____
3. Miscellaneous S _____ T _____ R _____
Property in Sec. S _____ T _____ R _____

4. Lot No. _____, Recorded Plat _____
5. Private Claims _____

Daniel E. Johnson June 21, 95

I, _____, in a field survey on _____, 19_____, do hereby certify that under requirements of P.A. 74, Michigan P.A. of 1970, the corner points mentioned in lines 1 and 2 above were in conformance with regulations and rules therefore as required in the current manual of survey instructions of the United States Department of the Interior, Bureau of Land Management or by a decree of a Court of Law and/or that the corner points mentioned in lines 3, 4 and 5 above were in conformance with the rules of the Michigan Board of Land Surveyors or by a Decree of a Court of Law; established, re-established, monumented, re-monumented, recovered, found as expressed below:

NOTE: Not more than 1 corner, may be recorded on this certificate.

A. Description of original monument and accessories and/or subsequent restoration:

LIBER 007 PAGE 116

STATE PLAIN COORDINATES


N. _____

E. _____

B. Description of corner evidence found and/or method applied in restoring or reestablishing corner:

LIBER 007 PAGE 116

ELEVATION _____

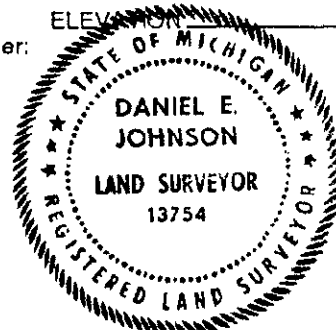

C. Description of monument for corner and accessories established to perpetuate locating the position of the corner:

Set 2" dia. aluminum cap inscribed "St Clair County Official Corner"
with magnet on a
Large Spike over Stone
S.W. 33.33 set PK nail & tag in 30" Locust
S.W. 148.70 ft. Set PK Nail & Tag in D.E. Pole
S.E. 142.35 ft. Set PK Nail & Tag in 15" Maple

Signed by

Daniel E. Johnson
Daniel E. Johnson
13754

Date June 21, 1995

Surveyor's Michigan License No. _____

PA 345-1990

PEER COMMITTEE

APPROVED AS AN OFFICIAL GOVERNMENT CORNER BY ST. CLAIR COUNTY:

Signed By:

St. Clair County Land Surveyor

Daniel E. Johnson

Date

Surveyor's Michigan License No. _____

13754

APPROVED 11-23-93

7-31-95

LIBER 008 PAGE 193