

ST. CLAIR COUNTY, MICHIGAN
OFFICIAL GOVERNMENT CORNER



LAND CORNER RECORDATION CERTIFICATE
Filing Requirement of Act 74, Mich. P.A. 1970

Located In: Corner Code #

1. Public Land Survey Wales Twp.
T 6N. R 15E. M-11
T _____ R _____
T _____ R _____
T _____ R _____
2. Property Controlling S _____ T _____ R _____
in Section S _____ T _____ R _____
3. Miscellaneous S _____ T _____ R _____
Property in Sec. S _____ T _____ R _____
- Seg 2*

RECEIVED
1995 APR -4 AM 10:25
Register of Deeds Stamp & File Number

4. Lot No. _____, Recorded Plat _____
5. Private Claims _____

Daniel E. Johnson January 31, 1995
I, _____, in a field survey on _____, 19____,
do hereby certify that under requirements of P.A. 74, Michigan P.A. of 1970, the corner points mentioned
in lines 1 and 2 above were in conformance with regulations and rules therefore as required in the
current manual of survey instructions of the United States Department of the Interior, Bureau of Land
Management or by a decree of a Court of Law and/or that the corner points mentioned in lines 3, 4 and 5
above were in conformance with the rules of the Michigan Board of Land Surveyors or by a Decree of a
Court of Law; established, re-established, monumented, re-monumented, recovered, found as
expressed below:

NOTE: Not more than 1 corner, may be recorded on this certificate.

- A. Description of original monument and accessories and/or subsequent restoration:

LIBER 007 PAGE 98

STATE PLAIN COORDINATES


N. _____

E. _____

- B. Description of corner evidence found and/or method applied in restoring or reestablishing corner:

LIBER 007 PAGE 98

ELEVATION _____

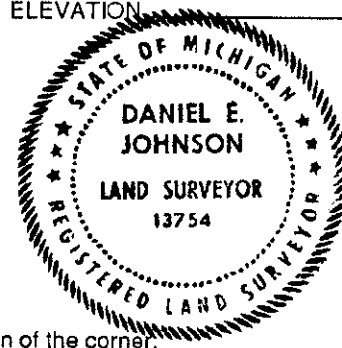

- C. Description of monument for corner and accessories established to perpetuate locating the position of the corner.
Set 2" dia. aluminum cap inscribed "St Clair County Official Corner"
with magnet (in monument box) on a
Concrete Monument (In Monument Box)
S.E. 80.05 ft. Set PK Nail and County Tag in D.E. Pole
S.W. 50.6 ft. Set PK Nail and County Tag in D.E. Pole
South 11.7 ft. to centerline of Exist. Asph. Pav't.
S.W. 55.1 ft. to Found Red Top Mon (damaged) (1936 Witness)
S.E. 45.5 ft. to center of S.E. Mich. Gas Pipeline marker.

Signed by

Daniel E. Johnson
Daniel E. Johnson
13754

Date January 31, 1995

Surveyor's Michigan License No. _____

PA 345-1990

PEER COMMITTEE

APPROVED AS AN OFFICIAL GOVERNMENT CORNER BY ST. CLAIR COUNTY:

Signed By:

St. Clair County Land Surveyor

Daniel E. Johnson
Daniel E. Johnson
13754

7-31-95

Date

Surveyor's Michigan License No. _____

LIBER 008 PAGE 188

APPROVED 11-16-93