

ST. CLAIR COUNTY, MICHIGAN
OFFICIAL GOVERNMENT CORNER



LAND CORNER RECORDATION CERTIFICATE
Filing Requirement of Act 74, Mich. P.A. 1970

Located In: Corner Code #

Kimball Twp.

1. Public Land Survey T ~~6N~~ R ~~16E~~ - G-1
T R
T R
T R
2. Property Controlling S T R
in Section S T R
3. Miscellaneous S T R
Property in Sec. S T R

4. Lot No. , Recorded Plat
5. Private Claims

RECEIVED
1995 AUG -4 AM 10:17
REGISTER OF DEEDS
ST. CLAIR COUNTY
Register of Deeds Stamp & File Number

I, Daniel E. Johnson, June 24, 1995, do hereby certify that under requirements of P.A. 74, Michigan P.A. of 1970, the corner points mentioned in lines 1 and 2 above were in conformance with regulations and rules therefore as required in the current manual of survey instructions of the United States Department of the Interior, Bureau of Land Management or by a decree of a Court of Law and/or that the corner points mentioned in lines 3, 4 and 5 above were in conformance with the rules of the Michigan Board of Land Surveyors or by a Decree of a Court of Law; established, re-established, monumented, re-monumented, recovered, found as expressed below:

NOTE: Not more than 1 corner, may be recorded on this certificate.

A. Description of original monument and accessories and/or subsequent restoration:

LIBER 007 PAGE 357

STATE PLAIN COORDINATES


N. _____

E. _____

ELEVATION _____

B. Description of corner evidence found and/or method applied in restoring or reestablishing corner:

LIBER 007 PAGE 357

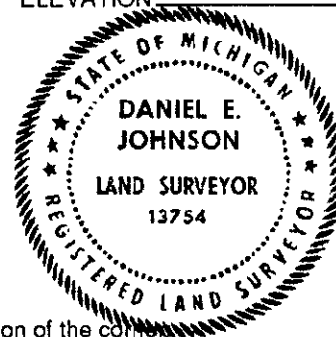

- C. Description of monument for corner and accessories established to perpetuate locating the position of the corner:
Set 2" dia. aluminum cap inscribed "St. Clair County Official Corner" with magnet. (In Monument Box) on a
3/4" square iron bar in monument box on exist. centerline of Lapeer Rd. Pgmt. Located 0.51' north of the true Township line.
EAST 11.6' to centerline of existing Ditty Rd. to south
S 04°W 48.47' to set PK nail w/county remon tag in W. side of power pole
S 70°E 137.11' to set PK nail w/county remon tag in NE side of power pole
N 69°30'E 127.40' to set PK nail w/county remon tag in SE side telephone pole
N 60°W 89.97' to set PK nail w/county remon tag in NW side telephone pole
WEST 2681.34' to N 1/4 corner of Section 4, T6N-R16E
EAST 2607.59' to N 1/4 corner of Section 3, T6N-R16E

Signed by _____

Date June 24, 1995

Surveyor's Michigan License No. Daniel E. Johnson #13754

PA 345-1990
PEER COMMITTEE

APPROVED AS AN OFFICIAL GOVERNMENT CORNER BY ST. CLAIR COUNTY:

Signed By: _____

St. Clair County Land Surveyor Daniel E. Johnson
#13754

Surveyor's Michigan License No. _____

APPROVED 6-17-94 Dmm

7-31-95

LIBER 008 PAGE 126