

ST. CLAIR COUNTY, MICHIGAN
OFFICIAL GOVERNMENT CORNER



LAND CORNER RECORDATION CERTIFICATE
Filing Requirement of Act 74, Mich. P.A. 1970

Located In: Corner Code #

Kimball Twp.

1. Public Land Survey

T 6N. R 16E. C-1

T R

T R

T R

2. Property Controlling
in Section

S T R

S T R

3. Miscellaneous

S T R

Property in Sec.

S T R

4. Lot No. , Recorded Plat

5. Private Claims

RECEIVED
1995 AUG -4 AM 10:17
REGISTER OF DEEDS
ST. CLAIR COUNTY
Register of Deeds Stamp & File Number

Daniel E. Johnson June 24, 95

I, in a field survey on 19 do hereby certify that under requirements of P.A. 74, Michigan P.A. of 1970, the corner points mentioned in lines 1 and 2 above were in conformance with regulations and rules therefore as required in the current manual of survey instructions of the United States Department of the Interior, Bureau of Land Management or by a decree of a Court of Law and/or that the corner points mentioned in lines 3, 4 and 5 above were in conformance with the rules of the Michigan Board of Land Surveyors or by a Decree of a Court of Law; established, re-established, monumented, re-monumented, recovered, found as expressed below:

NOTE: Not more than 1 corner, may be recorded on this certificate.

A. Description of original monument and accessories and/or subsequent restoration:

LIBER 007 PAGE 361

STATE PLAIN COORDINATES


N.

E.

	A	B	C	D	E	F	G	H	I	J	K	L	M
2	6	5	4	3	2	1							
3													
4	7	8	9	10	11	12							
5													
6	18	17	16	15	14	13							
7													
8	19	20	21	22	23	24							
9													
10	30	29	28	27	26	25							
11													
12	31	32	33	34	35	36							
13													

B. Description of corner evidence found and/or method applied in restoring or reestablishing corner:

LIBER 007 PAGE 361

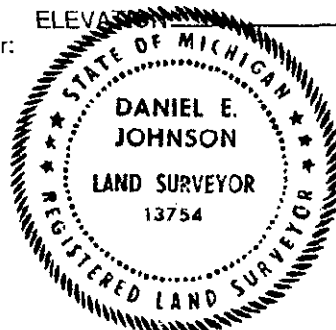

C. Description of monument for corner and accessories established to perpetuate locating the position of the corner:

Set 1/2" x 18" Rerod with 2" dia. aluminum cap inscribed "St. Clair County Official Corner" with magnet. (In monument box)

on centerline of existing Lapeer Rd. pavement in line with old fence to south. Located on the true Township line.

S 45°E 70.97' to set PK nail w/county remon tag in NE side power pole

N 45°E 65.72' to set PK nail w/county remon tag in NW side power pole

N 15°W 82.85' to set PK nail w/county remon tag in E side of 12" Pine Tree

S 70°W 145.38' to set PK nail w/county remon tag in NNW side of power pole

WEST 2663.44' to N 1/4 corner of Section 6, T6N-R16E

EAST 2660.28' to N 1/4 corner of Section 5, T6N-R16E

Signed by Daniel E. Johnson

Date June 24, 1995

Surveyor's Michigan License No. 13754

PA 345-1990

PEER COMMITTEE

APPROVED 6-17-94 DNE

APPROVED AS AN OFFICIAL GOVERNMENT CORNER BY ST. CLAIR COUNTY:

Signed By: Daniel E. Johnson

Date 7-31-95

St. Clair County Land Surveyor Daniel E. Johnson
13754

Date

Surveyor's Michigan License No.

LIBER 008 PAGE 122