

ST. CLAIR COUNTY, MICHIGAN
OFFICIAL GOVERNMENT CORNER



LAND CORNER RECORDATION CERTIFICATE
Filing Requirement of Act 74, Mich. P.A. 1970

1. Public Land Survey Located in: Port Huron Twp Corner Code #F-1 (Reference)
T 6N R 17E
T R
T R
T R
2. Property Controlling S T R
in Section S T R
3. Miscellaneous S T R
Property in Sec. S T R

Register of Deeds Stamp & File Number

4. Lot No. , Recorded Plat
5. Private Claims

Daniel E. Johnson May 11, 95
I, in a field survey on 19
do hereby certify that under requirements of P.A. 74, Michigan P.A. of 1970, the corner points mentioned in lines 1 and 2 above were in conformance with regulations and rules therefore as required in the current manual of survey instructions of the United States Department of the Interior, Bureau of Land Management or by a decree of a Court of Law and/or that the corner points mentioned in lines 3, 4 and 5 above were in conformance with the rules of the Michigan Board of Land Surveyors or by a Decree of a Court of Law; established, re-established, monumented, re-monumented, recovered, found as expressed below:

NOTE: Not more than 1 corner, may be recorded on this certificate.

A. Description of original monument and accessories and/or subsequent restoration:

LIBER 007 PAGE 375

STATE PLAIN COORDINATES


N. _____

E. _____

B. Description of corner evidence found and/or method applied in restoring or reestablishing corner:

LIBER 007 PAGE 375

ELEVATION _____

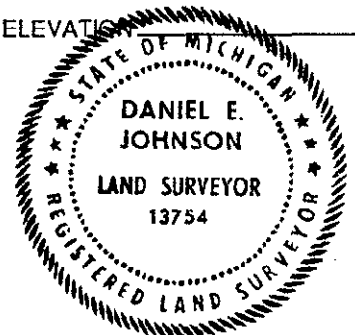

C. Description of monument for corner and accessories established to perpetuate locating the position of the corner:

Set 2" dia. aluminum cap inscribed "St. Clair County Official Corner" with magnet on a 3/4" rerod at margin (west bank) of Black River on centerline of West Water Street extended. Located on the true Township line.
E.N.E. 35.08' to SW corner of Detroit Edison Co. steel tower.
North 31.50 to W end of a steel seawall
South 47.60' to set PK nail with county remon tag in W side of guy pole
SE 36.00 to S end of a steel seawall
West 2135.56' to NW corner of Section 4, T6N-R17E
West 724.92' to 1/2 rerod in monument box on township line at centerline of intersection of Water Street and West Water Street.

Signed by Daniel E. Johnson Date May 11, 1995
13754

Surveyor's Michigan License No. _____

PA 345-1990
PEER COMMITTEE

APPROVED 6-10-94

APPROVED AS AN OFFICIAL GOVERNMENT CORNER BY ST. CLAIR COUNTY:

Signed By: Daniel E. Johnson Date 7-31-95
St. Clair County Land Surveyor

13754

Surveyor's Michigan License No. _____

LIBER 008 PAGE 171