

RECEIVED
ST. CLAIR COUNTY

SEP 20 PM 2:22

REGISTER OF DEEDS
ST. CLAIR COUNTY

ST. CLAIR COUNTY, MICHIGAN
OFFICIAL GOVERNMENT CORNER

LAND CORNER RECORDATION CERTIFICATE
Filing Requirement of Act 74, Mich. P.A. 1970



Located In:

Corner Code ~~##~~

1. Public Land Survey	T	7N	R	14E	I-13
	T		R		
	T		R		
	T		R		
2. Property Controlling in Section	S		T	R	Seg. 1
	S		T	R	
3. Miscellaneous Property in Sec.	S		T	R	
	S		T	R	

Register of Deeds Stamp & File Number

4. Lot No. _____, Recorded Plat _____
5. Private Claims _____

Michael J. Rossow

March 8,

94

I, _____, in a field survey on _____, 19_____, do hereby certify that under requirements of P.A. 74, Michigan P.A. of 1970, the corner points mentioned in lines 1 and 2 above were in conformance with regulations and rules therefore as required in the current manual of survey instructions of the United States Department of the Interior, Bureau of Land Management or by a decree of a Court of Law and/or that the corner points mentioned in lines 3, 4 and 5 above were in conformance with the rules of the Michigan Board of Land Surveyors or by a Decree of a Court of Law; established, re-established, monumented, re-monumented, recovered, found as expressed below:

NOTE: Not more than 1 corner, may be recorded on this certificate.

A. Description of original monument and accessories and/or subsequent restoration:

"Post" set original Government Survey

St. Clair Co. Surveyors Record List "1" Iron Pipe" As Corner.

Act 74 Cert. filed L.4,P.364 & L.6,P.299 (3/4" Iron Bar).
L.4,P.158 filed & rescinded in L.4,P.265.

B. Description of corner evidence found and/or method applied in restoring or reestablishing corner:

Found 1 1/4" pipe per Cert. L.4,P.364 & L.6,P.299.

C. Description of monument for corner and accessories established to perpetuate locating the position of the corner:

1 1/4" pipe.

161.25' SW to set P.K. and County Tag in 30" Ash.
94.76' SE to set P.K. and County Tag in P.Pole.
155.48' E to set P.K. and County Tag in Guard Rail Post
118.58' NW to set P.K. and County Tag in 24" Apple.

SEE ATTACHED SKETCH FOR ADDITIONAL INFORMATION.

Signed by Michael J. Rossow
Surveyor's Michigan License No. 24615

Date May 13, 1994
PA 345-1990
PEER COMMITTEE
APPROVED 5-20-94



APPROVED AS AN OFFICIAL GOVERNMENT CORNER BY ST. CLAIR COUNTY:

Signed By: _____ : _____
St. Clair County Land Surveyor

Surveyor's Michigan License No. _____

LIBER 007 PAGE 333

	A	B	C	D	E	F	G	H	I	J	K	L	M
2	6		5		4		3		2		1		
3													
4	7		8		9		10		11		12		
5													
6	18		17		16		15		14		13		
7													
8	19		20		21		22		23		24		
9													
10	30		29		28		27		26		25		
11													
12	31		32		33		34		35		36		
13													




STATE PLAIN COORDINATES

N. _____

E. _____

ELEVATION _____

HORTH

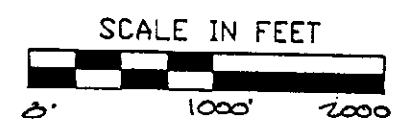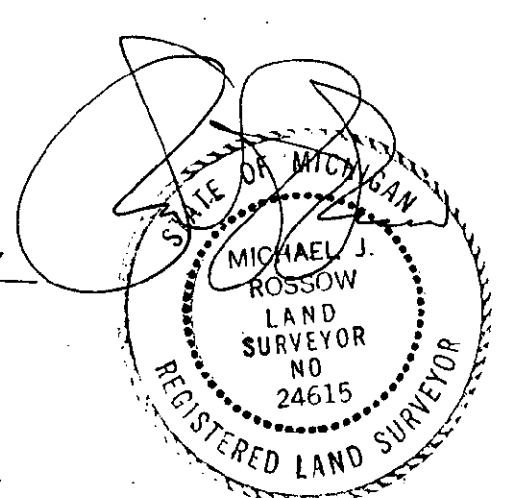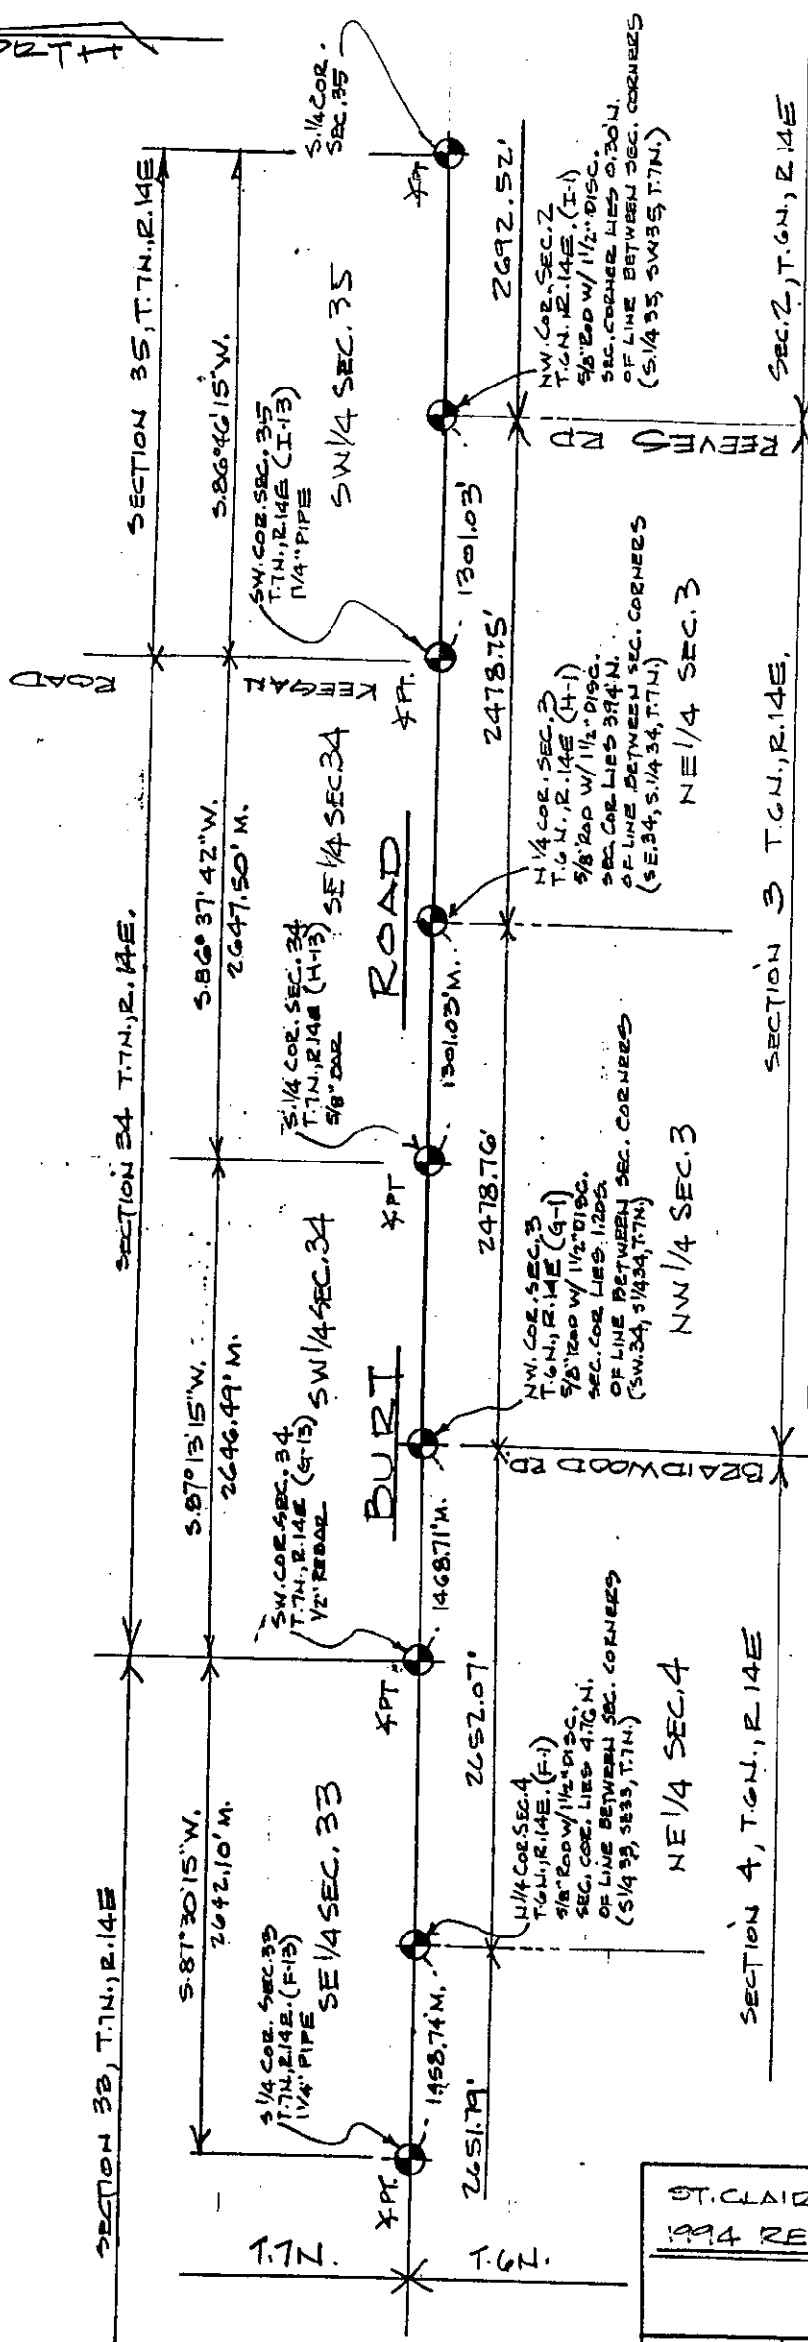

LEGEND	
○	SET IRON
●	FOUND IRON
○	RECORDED
○	MEASURED
○	CALCULATED
—x—x—	FENCE
—x—x—	GOVT. CORNER

NOTE: ALL DISTANCES & ANGLES
MEASURED ELECTRONICALLY

ST. CLAIR COUNTY, MICHIGAN			
1994 RE-MONUMENTATION PROGRAM			
DR BY	MZ	CK BY	MZ
SHEET NO	3	OF	SHEETS
DATE	4-26-94		
T.R. VALENTINE & ASSOCIATES INC.			
Consulting Engineers, Architects & Land Surveyors			
801 Huron Ave., Suite 8 Port Huron Michigan 48060 (313) 985-4848			
DWG NO	JOB NO		