

SURVEY &
REMONUMENTATION

JUL 14 1997

COMMISSION

ST. CLAIR COUNTY, MICHIGAN
OFFICIAL GOVERNMENT CORNER

LAND CORNER RECORDATION CERTIFICATE
Filing Requirement of Act 74, Mich. P.A. 1970



RECEIVED
REGISTER OF DEEDS
ST. CLAIR COUNTY
JUL 31 AM 8:01

	Located In:	Corner Code #
	Kenockee Township	
1. Public Land Survey	T <u>7N</u> R <u>15E</u>	<u>A-1</u>
	T _____ R _____	_____
	T _____ R _____	_____
	T _____ R _____	_____
2. Property Controlling	S _____ T _____ R _____	_____
in Section	S _____ T _____ R _____	_____
3. Miscellaneous	S _____ T _____ R _____	_____
Property in Sec.	S _____ T _____ R _____	_____

Register of Deeds Stamp & File Number

4. Lot No. _____, Recorded Plat _____
5. Private Claims _____

I, John C. Niederhauser, in a field survey on April 23, 19 96,
do hereby certify that under requirements of P.A. 74, Michigan P.A. of 1970, the corner points mentioned
in lines 1 and 2 above were in conformance with regulations and rules therefore as required in the
current manual of survey instructions of the United States Department of the Interior, Bureau of Land
Management or by a decree of a Court of Law and/or that the corner points mentioned in lines 3, 4 and 5
above were in conformance with the rules of the Michigan Board of Land Surveyors or by a Decree of a
Court of Law; established, re-established, monumented, re-monumented, recovered, found as
expressed below:

NOTE: Not more than 1 corner, may be recorded on this certificate.

	A	B	C	D	E	F	G	H	I	J	K	L	M
2		6		5		4		3		2		1	
3													
4		7		8		9		10		11		12	
5													
6		18		17		16		15		14		13	
7													
8		19		20		21		22		23		24	
9													
10		30		29		28		27		26		25	
11													
12		31		32		33		34		35		36	
13													

A. Description of original monument and accessories and/or subsequent restoration:

Joseph Wampler set a wood post in 1822 as the original government corner. It is a common corner to four (4) townships per the original field notes. Reference corners A-13 of T8N-R15E, M-1 of T7N-R14E and M-13 of T8N-R14E. Old County Surveyor's Record listed a 3/4" pipe. C. Alloway recovered and recorded a P.K. nail, L.C.R.C. Liber 4, Page 176. C. McDaniel recovered a P.K. nail and set and recorded a R.R. spike L.C.R.C. Liber 6, Page 335. J. Niederhauser found and recorded a R.R. spike L.C.R.C. Liber 6, Page 391. Also referenced BMJ surveyors dated 6-1-1989, 11-11-1991 and 8-5-1993, Collins surveys 11-23-1979 and 7-10-1974 and Alloway surveys dated 9-14-1975 and 2-10-1976.

B. Description of corner evidence found and/or method applied in restoring or reestablishing corner:

Found R.R. spike on centerline of Metcalf Road pavement east and west and Cork Road to the south and an old fence line to the north. Verified corner from found witnesses on recorded L.C.R.C. Liber 6, Page 391. Replaced R.R. spike with a 1/2" iron rorod and 2" dia. aluminum cap inscribed "St. Clair County Official Corner" set in a new monument road box.

C. Description of monument for corner and accessories established to perpetuate locating the position of the corner:

Set a 2" dia. aluminum cap with a magnet attached and inscribed "St. Clair County Official Corner" on a 1/2" iron rorod in a new monument road box. This corner marks the intersection of four (4) townships. For additional information reference corners M-1 of T7N-R14E, A-13 of T8N-R15E and M-13 of T8N-R14E.

North 29.78' to set P.K. nail with county remon tag in east side of power pole.

N.E. 99.81' to set P.K. nail with county remon tag in south side 8" Boxelder tree.

S.S.E. 101.94' to set P.K. nail with county remon tag in west side 10" Ash tree.

S.S.W. 93.49' to set P.K. nail with county remon tag in east side at the northeast corner of a wood barn.

East 2542.62' to the north quarter corner of Section 6, T7N-R15E.

South 2458.30' to the west quarter corner of Section 6, T7N-R15E.

Signed by

John C. Niederhauser


PA 345-1990
PEER COMMITTEE

APPROVED 7-12-96

Date

Daniel Johnson

Surveyor's Michigan License No. 24608

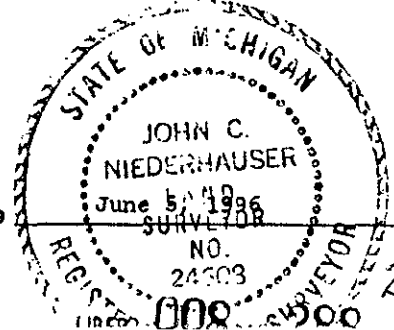

288