

ST. CLAIR COUNTY, MICHIGAN
OFFICIAL GOVERNMENT CORNER

LAND CORNER RECORDATION CERTIFICATE
Filing Requirement of Act 74, Mich. P.A. 1970



Located In: Corner Code #

1. Public Land Survey T 7N R 15E C-13
T _____ R _____
T _____ R _____
T _____ R _____
2. Property Controlling S _____ T _____ R _____
in Section S _____ T _____ R _____
3. Miscellaneous S _____ T _____ R _____
Property in Sec. S _____ T _____ R _____
4. Lot No. _____, Recorded Plat _____
5. Private Claims _____

REGISTERED
1993 DEC 29 AM 9:04
ST. CLAIR COUNTY
Register of Deeds Stamp & File Number

	A	B	C	D	E	F	G	H	I	J	K	L	M
2	6	5	4	3	2	1							
3													
4	7	8	9	10	11	12							
5													
6	18	17	16	15	14	13							
7													
8	19	20	21	22	23	24							
9													
10	30	29	28	27	26	25							
11													
12	31	32	33	34	35	36							
13													

David J. Little in a field survey on Sept. 27-30, 1993
do hereby certify that under requirements of P.A. 74, Michigan P.A. of 1970, the corner points mentioned in lines 1 and 2 above were in conformance with regulations and rules therefore as required in the current manual of survey instructions of the United States Department of the Interior, Bureau of Land Management or by a decree of a Court of Law and/or that the corner points mentioned in lines 3, 4 and 5 above were in conformance with the rules of the Michigan Board of Land Surveyors or by a Decree of a Court of Law; established, re-established, monumented, re-monumented, recovered, found as expressed below:

NOTE: Not more than 1 corner, may be recorded on this certificate.

- A. Description of original monument and accessories and/or subsequent restoration:

Post-(Government Surveys)

Nothing listed on Old Surveyor's Record
St. Clair County

This corner does not agree with certificate filed in
L.6 P.292 of Recordation Certificates.

STATE PLAIN COORDINATES

N. _____

E. _____

ELEVATION _____

- B. Description of corner evidence found and/or method applied in restoring or reestablishing corner:

Set "T" Iron Stamped LLS 31596

Set "T" Iron on line with the S $\frac{1}{4}$ Corner Section 32, T7N, R15E and the NW Corner Section 6, T6N, R15E, and on a line with the E $\frac{1}{4}$ Corner Section 32, T7N, R15E and found conc. monument 5.53' North. 2159A000 12/29/93SSRE4 2.00
0001

Note: This "T" Iron location does not agree with certificate filed in
L.6 P.292 by RLS 24601, the point specified in L.6 P.292 lies 5.53' North.

- C. Description of monument for corner and accessories established to perpetuate locating the position of the corner:

"T" Iron stamped LLS 31596.

2159A000 12/29/93SSSU4 11.00
0003

SE 74.95' to set P.K. and County Tag in NE face of corner fence post.
NE 105.60' to set P.K. and County Tag in NW face of Tele. Pole.
NW 44.65' to set P.K. and County Tag in S face of Tele Pole.
Ne 37.00' to set P.K. and County Tag in W face of railroad tie fence post.
Southerly at right angle to the centerline of railroad tracks 23.13'

See attached sketch for additional information.

Signed by _____

David J. Little


Date December 10

Surveyor's Michigan License No. 31596

PA 345-1990

PEER COMMITTEE

APPROVED 12-14-93

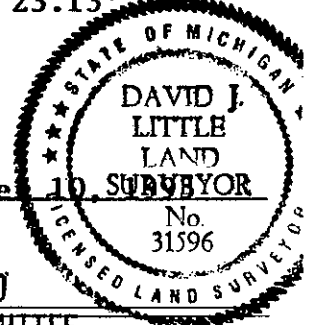

APPROVED AS AN OFFICIAL GOVERNMENT CORNER BY ST. CLAIR COUNTY:

By: _____

St. Clair County Land Surveyor

Date

Michigan License No. _____

LIBER 007 PAGE 177