

ST. CLAIR COUNTY, MICHIGAN  
OFFICIAL GOVERNMENT CORNER



LAND CORNER RECORDATION CERTIFICATE  
Filing Requirement of Act 74, Mich. P.A. 1970

Located In: Corner Code #

1. Public Land Survey T 7N. R 15E. -C-13  
T \_\_\_\_\_ R \_\_\_\_\_  
T \_\_\_\_\_ R \_\_\_\_\_  
T \_\_\_\_\_ R \_\_\_\_\_  
2. Property Controlling S \_\_\_\_\_ T \_\_\_\_\_ R \_\_\_\_\_  
in Section S \_\_\_\_\_ T \_\_\_\_\_ R \_\_\_\_\_  
3. Miscellaneous S \_\_\_\_\_ T \_\_\_\_\_ R \_\_\_\_\_  
Property in Sec. S \_\_\_\_\_ T \_\_\_\_\_ R \_\_\_\_\_

4. Lot No. \_\_\_\_\_, Recorded Plat \_\_\_\_\_  
5. Private Claims \_\_\_\_\_

RECEIVED  
REGISTER OF DEEDS  
ST. CLAIR COUNTY  
1995 AUG -4 AM 10:15  
Register of Deeds Stamp & File Number

**Daniel E. Johnson** May 25, 1995  
I, \_\_\_\_\_, in a field survey on \_\_\_\_\_, 19\_\_\_\_\_,  
do hereby certify that under requirements of P.A. 74, Michigan P.A. of 1970, the corner points mentioned  
in lines 1 and 2 above were in conformance with regulations and rules therefore as required in the  
current manual of survey instructions of the United States Department of the Interior, Bureau of Land  
Management or by a decree of a Court of Law and/or that the corner points mentioned in lines 3, 4 and 5  
above were in conformance with the rules of the Michigan Board of Land Surveyors or by a Decree of a  
Court of Law; established, re-established, monumented, re-monumented, recovered, found as  
expressed below:

NOTE: Not more than 1 corner, may be recorded on this certificate.

- A. Description of original monument and accessories and/or subsequent restoration:

LIBER 007 PAGE 177


STATE PLAIN COORDINATES

N. \_\_\_\_\_

E. \_\_\_\_\_

- B. Description of corner evidence found and/or method applied in restoring or reestablishing corner:

LIBER 007 PAGE 177

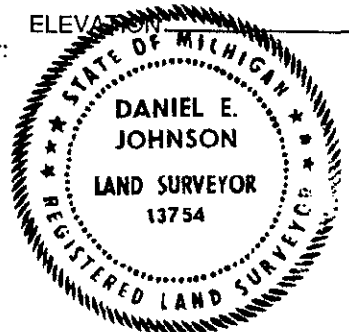

- C. Description of monument for corner and accessories established to perpetuate locating the position of the corner:  
Set with 2" dia. aluminum cap inscribed "St. Clair County Official Corner" with magnet  
on a  
"T" Iron stamped LLS 31596.

SE 74.95' to set PK and County Tag in NE face of corner fence post  
NE 105.60' to set PK and County Tag in NW face of telephone pole  
NW 44.65' to set PK and County Tag in S face of telephone pole  
NE 37.00' to set PK and County Tag in W face of railroad tie fence post  
Southerly at right angle to the centerline of railroad tracks 23.13'

Signed by Daniel E. Johnson Date May 25, 1995  
Surveyor's Michigan License No. #13754

PA 345-1990  
PEER COMMITTEE

APPROVED AS AN OFFICIAL GOVERNMENT CORNER BY ST. CLAIR COUNTY:

Signed By: Daniel E. Johnson Date 7/31/95  
St. Clair County Land Surveyor Daniel E. Johnson  
Surveyor's Michigan License No. #13754

LIBER 008 PAGE 109