

ST. CLAIR COUNTY, MICHIGAN OFFICIAL GOVERNMENT CORNER



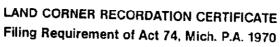

	Located In:	Corner Code ##	
Public Land Survey	T <u>7N</u> R <u>15E</u> T R T R	D-13	1893 GEC REGIST ST. CL
In Section S Miscellaneous S	T R T R T R T R	Jeg. 1	Register of Deeds Stamp & File Number
Lot No, Recor			1 1 1 1 1 1 1 1 1 1 1 1 1 1 1 1 1 1 1
Private Claims	Sec 1 rat		A B C D E F G H I J K L N
			3
David J. Little in a partial of the	nents of P.A. 74, Michigan P.A. of formance with regulations and its of the United Stales Department of Law and/or that the corner rules of the Michigan Board of ablished, monumented, re-modelished.	f 1970, the corner points mentioned rules therefore as required in the nent of the Interior, Bureau of Landpoints mentioned in lines 3, 4 and 5 Land Surveyors or by a Decree of a polymented, recovered, found as	18 17 16 15 14 13 13 13 14 13 13 14 13 13 14 15 15 16 16 16 16 16 16 16 16 16 16 16 16 16
OTE: Not more than 1 corner	, may be recorded on this o	certificate.	11
Description of original monum Post-(Government	nent and accessories and/or Surveys)	subsequent restoration:	STATE PLAIN COORDINATES
Nothing listed or St. Clair County	n Old Surveyor's	Record	N
Corner recorded in Iron Rod set by I	in L.6 P.4 Recore	dation Certificate	E
Description of corner evidence Found Iron Rod wi	e found and/or method applicith cap stamped	ed in restoring or reestablishing 24615	corner:
This corner agree as recorded in L.	es with location .6 P.4.	shown on certific	ate filed by RLS 24615
			2159A000 12/29/93HSSU4 9.00 **0001**
			2159A000 12/29/93SSRE% 2.00
Description of monument for a Iron Rod with cap		olished to perpetuate locating th	
NE 16.16' to set SW 85.25' to set	P.K. and County P.K. and County	Tag in S face of Tag in SE face of Tag in S face of	10" Poplar DAVID I. 18" Ash. LITTLE LAND
See attached sket	ch for additiona	al information.	SURVEYOR No. 31596
aned by Marie	for	Date _	December 10, 1993
, ————————————————————————————————————	J. Little 31596		PA 345-1990
			PEER COMMITTEE
PPROVED AS AN OFFICIAL GO	OVERNMENT CORNER BY	ST. CLAIR COUNTY:	APPROVED_12-14-93
gned By:		· 	
St. Clair County Lan	d Surveyor		Date

Burveyor's Michigan License No.

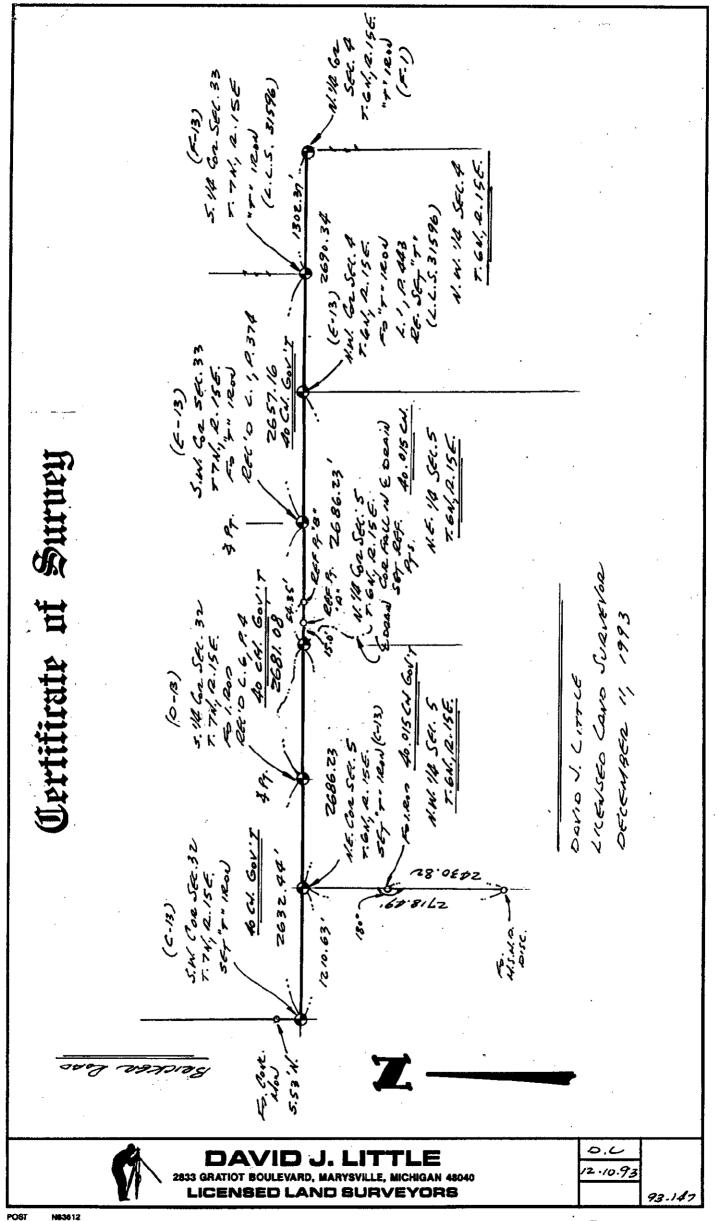

N63612