

ST. CLAIR COUNTY, MICHIGAN
OFFICIAL GOVERNMENT CORNER



LAND CORNER RECORDATION CERTIFICATE
Filing Requirement of Act 74, Mich. P.A. 1970

Located In: Corner Code ##

1. Public Land Survey T 7N., R 15E., G-13
T R
T R
T R
2. Property Controlling S T R
in Section S T R
3. Miscellaneous S T R
Property in Sec. S T R

4. Lot No. , Recorded Plat
5. Private Claims

RECEIVED
1995 AUG - 4 AM 10:15
REGISTER OF DEEDS
ST. CLAIR COUNTY
Register of Deeds Stamp & File Number

Daniel E. Johnson May 26, 95
I, in a field survey on 19
do hereby certify that under requirements of P.A. 74, Michigan P.A. of 1970, the corner points mentioned in lines 1 and 2 above were in conformance with regulations and rules therofore as required in the current manual of survey instructions of the United States Department of the Interior, Bureau of Land Management or by a decree of a Court of Law and/or that the corner points mentioned in lines 3, 4 and 5 above were in conformance with the rules of the Michigan Board of Land Surveyors or by a Decree of a Court of Law; established, re-established, monumented, re-monumented, recovered, found as expressed below:

NOTE: Not more than 1 corner, may be recorded on this certificate.

A. Description of original monument and accessories and/or subsequent restoration:

LIBER 007 PAGE 161


STATE PLAIN COORDINATES

N. _____
E. _____

ELEVATION _____

B. Description of corner evidence found and/or method applied in restoring or reestablishing corner:

LIBER 007 PAGE 161

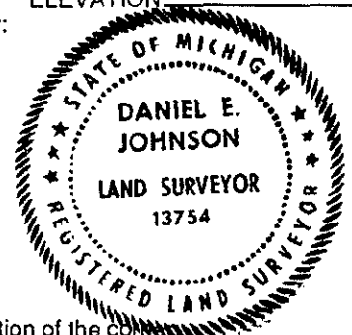

C. Description of monument for corner and accessories established to perpetuate locating the position of the corner:
Set 1/2" x 18" Rerod in 1" Iron Pipe with 2" dia. aluminum cap inscribed "St. Clair County Official Corner" with magnet.

S.E. 52.08' to PK and County Tag in W. face of D.E.P.
S.S.E. 126.40' to PK and County Tag in W. face of 36' Oak
N.E. 73.70' to PK and County Tag in N W. face of 12" Ash
W. 41.62' to PK and County Tag in S. face of 10" Ash

Signed by Daniel E. Johnson Date May 26, 1995
Daniel E. Johnson
Surveyor's Michigan License No. 13754

PA 345-1990
PEER COMMITTEE
APPROVED 12-7-93

APPROVED AS AN OFFICIAL GOVERNMENT CORNER BY ST. CLAIR COUNTY:
Signed By: Daniel E. Johnson : 7-31-95
St. Clair County Land Surveyor Daniel E. Johnson
Surveyor's Michigan License No. 13754
Date
LIBER 008 PAGE 113