

ST. CLAIR COUNTY, MICHIGAN
OFFICIAL GOVERNMENT CORNER



LAND CORNER RECORDATION CERTIFICATE
Filing Requirement of Act 74, Mich. P.A. 1970

Located In: Corner Code ##

1. Public Land Survey T 7N R 15E J-13
T _____ R _____
T _____ R _____
T _____ R _____
2. Property Controlling S _____ T _____ R _____
in Section S _____ T _____ R _____
3. Miscellaneous S _____ T _____ R _____
Property in Sec. S _____ T _____ R _____

Seg. 1

1993 DEC 29 AM 03
RECEIVED
REGISTER OF DEEDS
ST. CLAIR COUNTY, MICHIGAN
Register of Deeds Stamp & File Number

4. Lot No. _____, Recorded Plat _____
5. Private Claims _____

I, David J. Little in a field survey on November 23, 19 93
do hereby certify that under requirements of P.A. 74, Michigan P.A. of 1970, the corner points mentioned
in lines 1 and 2 above were in conformance with regulations and rules therefore as required in the
current manual of survey instructions of the United States Department of the Interior, Bureau of Land
Management or by a decree of a Court of Law and/or that the corner points mentioned in lines 3, 4 and 5
above were in conformance with the rules of the Michigan Board of Land Surveyors or by a Decree of a
Court of Law; established, re-established, monumented, re-monumented, recovered, found as
expressed below:

	A	B	C	D	E	F	G	H	I	J	K	L	M
2	6	5	4	3	2	1							
3													
4	7	8	9	10	11	12							
5													
6	18	17	16	15	14	13							
7													
8	19	20	21	22	23	24							
9													
10	30	29	28	27	26	25							
11													
12	31	32	33	34	35	36							
13													

NOTE: Not more than 1 corner, may be recorded on this certificate.

A. Description of original monument and accessories and/or subsequent restoration:
Post-(Government Surveys)
Corner not indentified on Old Surveyor's Record
St. Clair County.
No Certificate filed on this corner.
STATE PLAIN COORDINATES
N. _____
E. _____
ELEVATION _____

B. Description of corner evidence found and/or method applied in restoring or reestablishing corner:
Found 1" Iron Pin in Monument Box 10" below road surface.
Corner verified by 1930 Michigan State Highway Department Plans.
Found Iron rod stamped RLS 19835 6.6' West and 1'± North.
Corner agrees with fence running North
2159A000 12/29/93HSSU7 9.00
0001
2159A000 12/29/93SSRE4 2.00
0001

C. Description of monument for corner and accessories established to perpetuate locating the position of the corner:
1" Iron Pin in Monument Box.
N. 65.0' to set P.K. and County Tag in E. face of Tele. Pole.
NNE 101.0 to set P.K. and County Tag in W. face of D.E.P.
ENE 120.22' to set P.K. and County Tag in NW face of 24" Ash
SE 65.05' to set P.K. and County Tag in NE face of D.E.P.
See attached sketch for additional information.
(Corner is on centerline of existing Lapeer Road pavement)




Signed by David L. Little Date November 29, 1993
Surveyor's Michigan License No. 31596

PA 345-1990
PEER COMMITTEE
APPROVED 12-14-93

APPROVED AS AN OFFICIAL GOVERNMENT CORNER BY ST. CLAIR COUNTY:
Signed By: _____ Date _____
St. Clair County Land Surveyor

Certificate of Survey

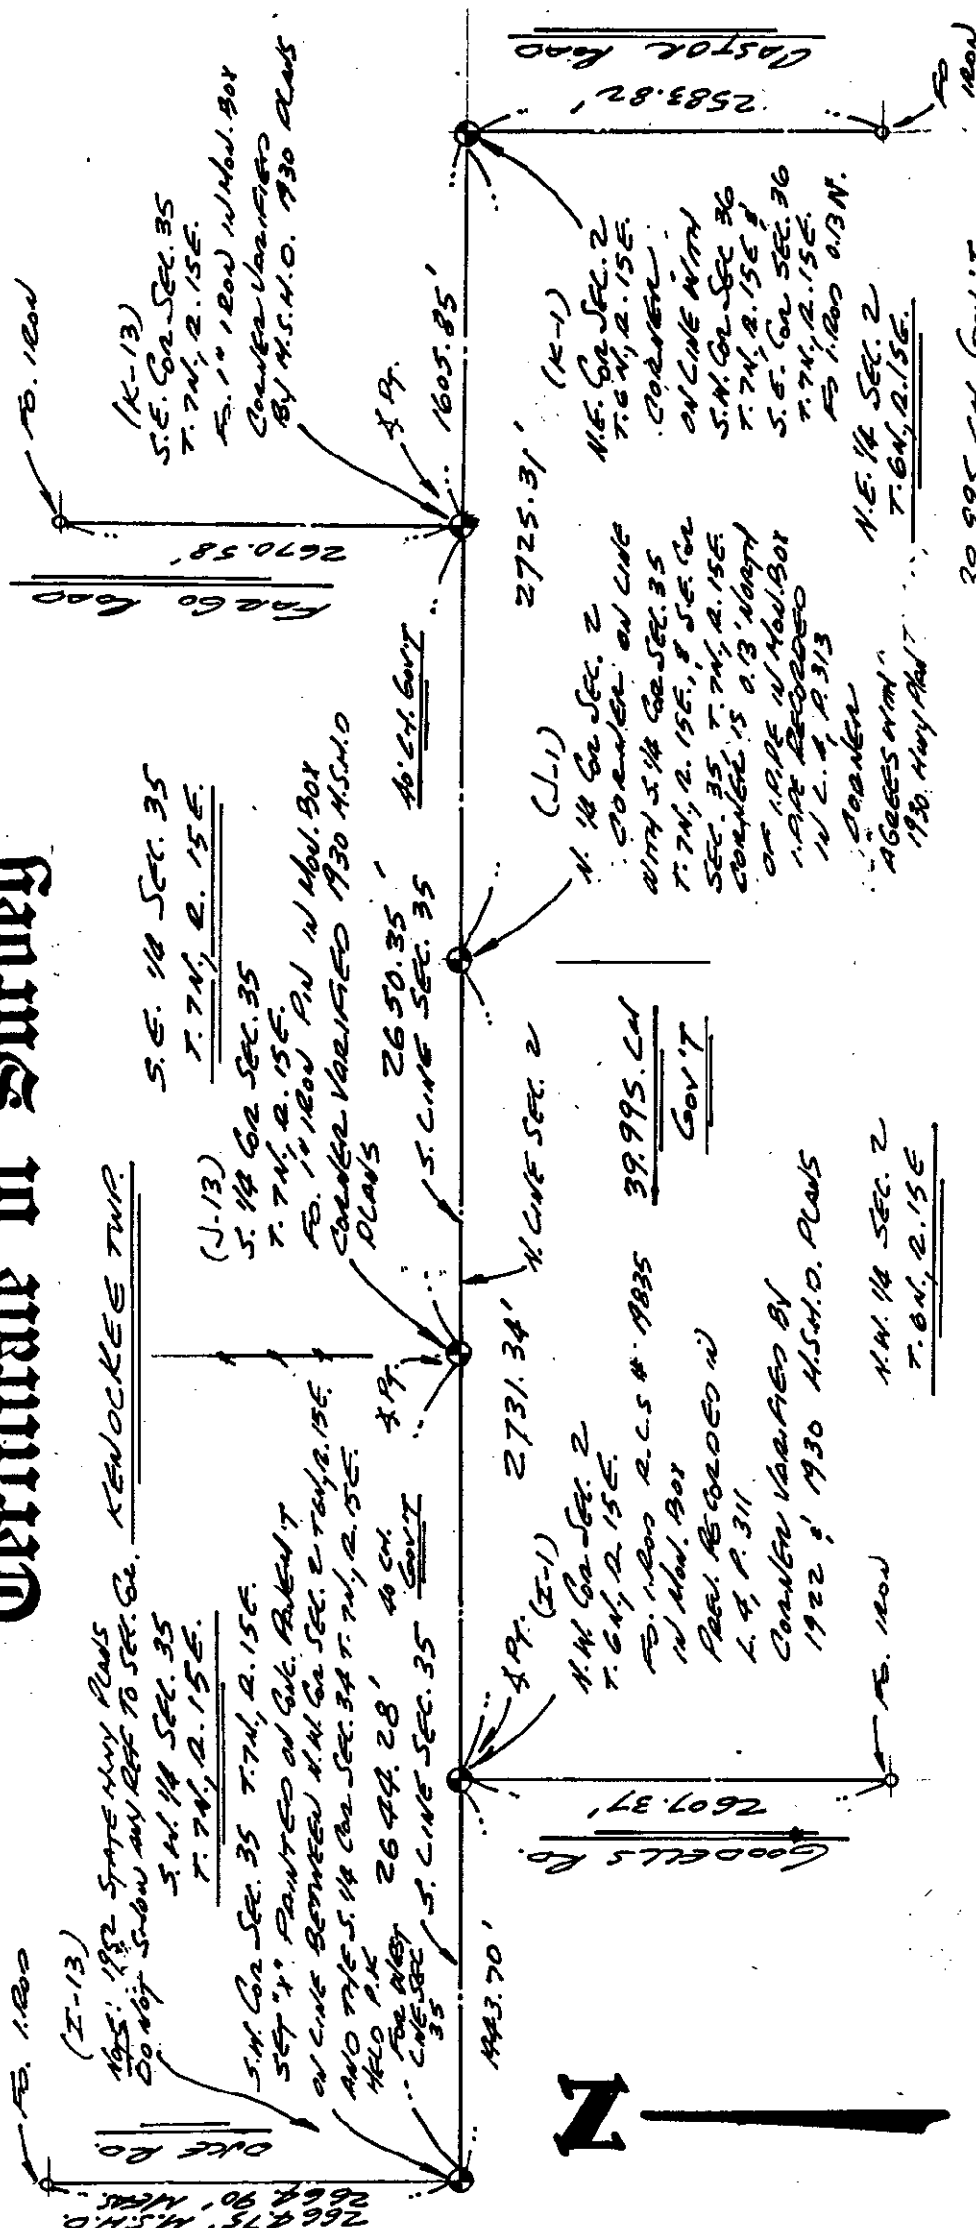

NOTE: ALL DIST.
MENS. D.M.E.

DAVID J. CITTLE
KNOXSD CARD SUPERVISOR
NOVEMBER 20, 1993

WALLES TWP.

39.995 ea. Gov. T

DAVID J. LITTLE

2833 GRATIOT BOULEVARD, MARYSVILLE, MICHIGAN 48040
LICENSED LAND SURVEYORS

D.L.
11.20.93
1"=600

93.147