

ST. CLAIR COUNTY, MICHIGAN
OFFICIAL GOVERNMENT CORNER

LAND CORNER RECORDATION CERTIFICATE
Filing Requirement of Act 74, Mich. P.A. 1970



RECEIVED
REGISTER OF DEEDS
ST. CLAIR COUNTY
1995 AUG -4 AM 10:16
Register of Deeds Stamp & File Number

Located In: Corner Code ##

1 Public Land Survey T 7N. R 15E. L-13
T _____ R _____
T _____ R _____
T _____ R _____

2 Property Controlling S _____ T _____ R _____
in Section S _____ T _____ R _____ Seg. 2
3 Miscellaneous S _____ T _____ R _____
Property in Sec. S _____ T _____ R _____

4 Lot No. _____, Recorded Plat _____
5 Private Claims _____

	A	B	C	D	E	F	G	H	I	J	K	L	M
2	6		5		4		3		2		1		
3													
4	7		8		9		10		11		12		
5													
6	16		17		18		19		20		21		
7													
8	19		20		21		22		23		24		
9													
10	30		29		28		27		26		25		
11													
12	31		32		33		34		35		36		
13													

Daniel E. Johnson May 26, 95
I, _____, in a field survey on _____, 19_____,
do hereby certify that under requirements of P.A. 74, Michigan P.A. of 1970, the corner points mentioned
in lines 1 and 2 above were in conformance with regulations and rules therefore as required in the
current manual of survey instructions of the United States Department of the Interior, Bureau of Land
Management or by a decree of a Court of Law and/or that the corner points mentioned in lines 3, 4 and 5
above were in conformance with the rules of the Michigan Board of Land Surveyors or by a Decree of a
Court of Law; established, re-established, monumented, re-monumented, recovered, found as
expressed below:

NOTE: Not more than 1 corner, may be recorded on this certificate.

A. Description of original monument and accessories and/or subsequent restoration:

LIBER 007 PAGE 140


STATE PLAIN COORDINATES

N. _____
E. _____

ELEVATION _____

B. Description of corner evidence found and/or method applied in restoring or reestablishing corner:

LIBER 007 PAGE 140

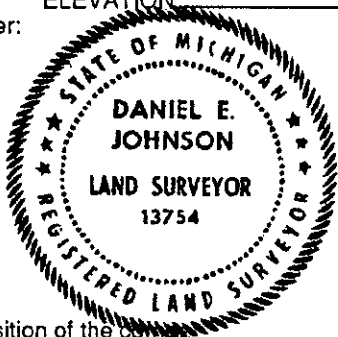

C. Description of monument for corner and accessories established to perpetuate locating the position of the corner:
Set with 2" dia. aluminum cap inscribed "St. Clair County Official Corner" with magnet
(In Monument Box)
on an
Iron Pin in Monument Box.
SW 70.2' to set PK and County Tag in NW face of D.E.P.
NW 127.47' to set PK and County Tag in W face of D.E.P.
NE 55.40' to set PK and County Tag in W face of D.E.P.
SE 149.80' to set PK and County Tag in N face of D.E.P.

(Corner is on centerline of existing Lapeer Rd. pavement)

Signed by Daniel E. Johnson Date May 26, 1995
Surveyor's Michigan License No. Daniel E. Johnson
#13754

PA 345-1990
PEER COMMITTEE

APPROVED 12-7-93
Davis

APPROVED AS AN OFFICIAL GOVERNMENT CORNER BY ST. CLAIR COUNTY:
Signed By: Daniel E. Johnson
St. Clair County Land Surveyor Daniel E. Johnson
#13754
Surveyor's Michigan License No. _____

7-31-95
Date
LIBER 008 PAGE 118