

ST. CLAIR COUNTY, MICHIGAN  
OFFICIAL GOVERNMENT CORNER



LAND CORNER RECORDATION CERTIFICATE  
Filing Requirement of Act 74, Mich. P.A. 1970

Located In:

Corner Code #

1. Public Land Survey

T 7N. R 15E.

H-13

2. Property Controlling  
in Section

S T R

3. Miscellaneous  
Property in Sec.

S T R

Leg 2

RECEIVED  
REGISTER OF DEEDS  
ST. CLAIR COUNTY  
1995 AUG -4 AM 10:15

Register of Deeds Stamp & File Number

4. Lot No. , Recorded Plat

5. Private Claims

Daniel E. Johnson

May 26,

95

I, in a field survey on , 19 do hereby certify that under requirements of P.A. 74, Michigan P.A. of 1970, the corner points mentioned in lines 1 and 2 above were in conformance with regulations and rules therefore as required in the current manual of survey instructions of the United States Department of the Interior, Bureau of Land Management or by a decree of a Court of Law and/or that the corner points mentioned in lines 3, 4 and 5 above were in conformance with the rules of the Michigan Board of Land Surveyors or by a Decree of a Court of Law; established, re-established, monumented, re-monumented, recovered, found as expressed below:

NOTE: Not more than 1 corner, may be recorded on this certificate.

A. Description of original monument and accessories and/or subsequent restoration:

LIBER 007 PAGE 157

STATE PLAIN COORDINATES


N. \_\_\_\_\_

E. \_\_\_\_\_

ELEVATION \_\_\_\_\_

B. Description of corner evidence found and/or method applied in restoring or reestablishing corner:

LIBER 007 PAGE 157

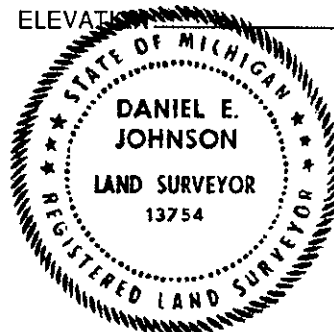

C. Description of monument for corner and accessories established to perpetuate locating the position of the corner:

Set 1/2" x 18" Rerod inside 3/4" Iron Pipe with 2" dia. aluminum cap inscribed "St. Clair County Official Corner" with magnet (In monument box)

N.E. 151.53' to PK and County Tag in utility pole  
S.W. 26.92' to N.E. corner of conc. headwall  
S.E. 36.50' to N.W. corner of conc. headwall  
N. 132.05' to PK and County Tag in S.E. face of 12" Maple

Signed by

Daniel E. Johnson

Date

May 26, 1995

Surveyor's Michigan License No.

13754

PA 345-1990

PEER COMMITTEE

APPROVED 12-14-93

APPROVED AS AN OFFICIAL GOVERNMENT CORNER BY ST. CLAIR COUNTY:

Signed By:

Daniel E. Johnson

7-31-95

St. Clair County Land Surveyor

Daniel E. Johnson  
13754

Date

Surveyor's Michigan License No.

LIBER 008 PAGE 114