

ST. CLAIR COUNTY, MICHIGAN
OFFICIAL GOVERNMENT CORNER

LAND CORNER RECORDATION CERTIFICATE
Filing Requirement of Act 74, Mich. P.A. 1970



RECEIVED
REGISTER OF DEEDS
ST. CLAIR COUNTY
1995 AUG -4 AM 10:16

Register of Deeds Stamp & File Number

Located In: Corner Code #

1. Public Land Survey T 7N. R 15E. J-13
T _____ R _____
T _____ R _____
T _____ R _____
2. Property Controlling S _____ T _____ R _____
in Section S _____ T _____ R _____
3. Miscellaneous S _____ T _____ R _____
Property in Sec. S _____ T _____ R _____

4. Lot No. _____, Recorded Plat _____
5. Private Claims _____

Daniel E. Johnson May 26, 1995

I, _____, in a field survey on _____, 19____, do hereby certify that under requirements of P.A. 74, Michigan P.A. of 1970, the corner points mentioned in lines 1 and 2 above were in conformance with regulations and rules therefore as required in the current manual of survey instructions of the United States Department of the Interior, Bureau of Land Management or by a decree of a Court of Law and/or that the corner points mentioned in lines 3, 4 and 5 above were in conformance with the rules of the Michigan Board of Land Surveyors or by a Decree of a Court of Law; established, re-established, monumented, re-monumented, recovered, found as expressed below:

NOTE: Not more than 1 corner, may be recorded on this certificate.

- A. Description of original monument and accessories and/or subsequent restoration:

LIBER 007 PAGE 152

STATE PLAIN COORDINATES


N. _____

E. _____

ELEVATION _____

- B. Description of corner evidence found and/or method applied in restoring or reestablishing corner:

LIBER 007 PAGE 152

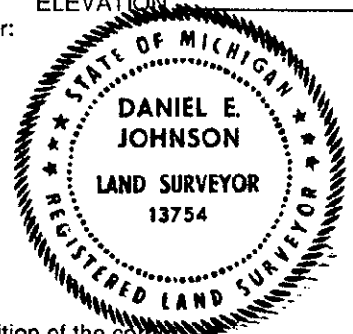

- C. Description of monument for corner and accessories established to perpetuate locating the position of the corner.
Set 1/2" x 18" Rerod with 2" dia. aluminum cap inscribed "St. Clair County Official Corner" with magnet (In Monument Box)

N. 65.0' to set PK and County Tag in E. face of Telephone Pole
NNE 101.0' to set PK and County Tag in W. face of D.E.P.
ENE 120.22' to set PK and County Tag in NW face of 24" Ash
SE 65.05' to set PK and County Tag in NE face of D.E.P.

(Corner is on centerline of existing Lapeer Rd. pavement)

Signed by _____ Date **May 26, 1995**

Surveyor's Michigan License No. **Daniel E. Johnson**
#13754

APPROVED AS AN OFFICIAL GOVERNMENT CORNER BY ST. CLAIR COUNTY:

Signed By: _____

St. Clair County Land Surveyor **Daniel E. Johnson**

Surveyor's Michigan License No. **#13754**

7-31-95 PA 345-1990
PEER COMMITTEE
Date **12-14-93**
APPROVED
LIBER **008** PAGE **116**