

ST. CLAIR COUNTY, MICHIGAN
OFFICIAL GOVERNMENT CORNER

LAND CORNER RECORDATION CERTIFICATE
Filing Requirement of Act 74, Mich. P.A. 1970



REGISTERED
ST. CLAIR COUNTY
975 APR -4 AM 10:22

RECEIVED

Register of Deeds Stamp & File Number

Located In: Corner Code #

Port Huron Twp.

T7N R17E B-13

T R

T R

T R

S T R

S T R

S T R

S T R

1. Public Land Survey

2. Property Controlling
in Section

3. Miscellaneous
Property in Sec.

4. Lot No. , Recorded Plat

5. Private Claims

Daniel E. Johnson

May 11,

95

I, in a field survey on , 19 ,
do hereby certify that under requirements of P.A. 74, Michigan P.A. of 1970, the corner points mentioned
in lines 1 and 2 above were in conformance with regulations and rules therefore as required in the
current manual of survey instructions of the United States Department of the Interior, Bureau of Land
Management or by a decree of a Court of Law and/or that the corner points mentioned in lines 3, 4 and 5
above were in conformance with the rules of the Michigan Board of Land Surveyors or by a Decree of a
Court of Law; established, re-established, monumented, re-monumented, recovered, found as
expressed below:

NOTE: Not more than 1 corner, may be recorded on this certificate.

A. Description of original monument and accessories and/or subsequent restoration:

LIBER 007 PAGE 386

STATE PLAIN COORDINATES


N. _____

E. _____

ELEVATION _____

B. Description of corner evidence found and/or method applied in restoring or reestablishing corner:

LIBER 007 PAGE 386

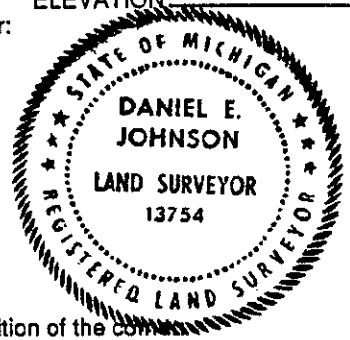

C. Description of monument for corner and accessories established to perpetuate locating the position of the corner:
Set 2"dia. aluminum cap inscribed "St. Clair County Official Corner" with magnet

in monument box on centerline of exist. W Water St. pavement and Range Road
pavement to North. Located on the true Township line.

S29°W 47.95' to set PK nail w/county remon tag in N side of power pole

N 30°W 62.27' to set PK nail w/county remon tag in W side of power pole

N 38°E 80.70' to set PK nail w/county remon tag in NW side of 10" apple tree

S 60°E 129.74' to set PK nail w/county remon tag in NE side of 8" maple tree

WEST 2648.66' to SW corner of Section 31, T6N-R17E

EAST 2647.23' to SE corner of Section 31, T7N-R17E

Daniel E. Johnson

Date May 11, 1995

Surveyor's Michigan License No. Daniel E. Johnson #13754

PA 345-1990

PEER COMMITTEE

APPROVED 6-10-94

APPROVED AS AN OFFICIAL GOVERNMENT CORNER BY ST. CLAIR COUNTY:

Signed By: *Daniel E. Johnson*

7-31-95

Don I

St. Clair County Land Surveyor Daniel E. Johnson
13754

Date

Surveyor's Michigan License No. _____

LIBER 008 PAGE 160