

SURVEY & REMONUMENTATION

NOV 30 1993

FILED

COMMISSION

004 PG 013

LAND CORNER RECORDATION CERTIFICATE
Filing Requirement of Act 74, Mich. P.A. 1970

OCT 7 11 05 AM '93

or corners in

ST. JOSEPH

(County)

Located In:

Corner Code ##

LEONIDAS TWP.

Public Land Survey

T 5S R 9W

A-13

T R

T R

T R

T R

Property Controlling

S

T R

in Section

S

T R

Miscellaneous

S

T R

Property in Sec.

S

T R

Cynthia L. Janett
REGISTER OF DEEDS
ST. JOSEPH CO MICH

Register of Deeds Stamp & File Number

Lot No. , Recorded Plat

Private Claims

WAYNE A. MOSTROM, in a field survey on MAY 10, 1993, hereby certify that under requirements of P.A. 74, Michigan P.A. of 1970, the corner points mentioned in lines 1 and 2 above were in conformance with regulations and rules therefore as required in the current manual of survey instructions of the United States Department of the Interior, Bureau of Land Management or by a decree of a Court of Law and/or that the corner points mentioned in lines 3, 4 and 5 above were in conformance with the rules of the Michigan Board of Land Surveyors or by a Decree of a Court of Law; established, re-established, monumented, re-monumented, recovered, found as pressed below:

NOTE: Not more than 4 corners, all in the same town and range, may be recorded on this certificate.

Description of original monument and accessories and/or subsequent restoration:

GLO

MDOT - 1961

SAYERS 1976 SURVEY

"EARTHEN MOUND"

FD. LARGE POINTED STONE
WITH 1" PIPE

MON BOX OVER BOAT SPIKE


NO RECORDS IN
BOOKS 1, A OR B

18" WAL = NORTH 32.4'
21" MAPLE = N40°E 69.9'
18" MAPLE = S60°E 52.72'

SW COR. HSE. = N31°E 73.5'
SE COR HSE. = N51°30'E 105.4'

Description of corner evidence found and/or method applied in restoring or reestablishing corner:

FD. BOAT SPIKE OVER STONE IN MON BOX
18" MAPLE = S60°E 52.72'

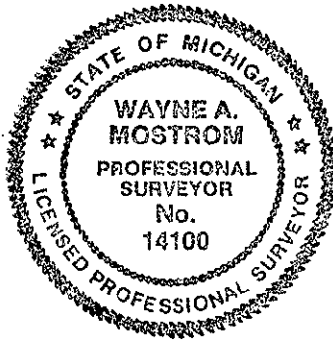

Description of monument for corner and accessories established to perpetuate locating the position of the corner:

SET 5/8" X 24" BAR W/STD COUNTY CAP IN MON. BOX
C PAV'MT = NORTH 2.8'
NW ON E SIDE 36" OAK = N5°E 115.16'
SW COR HOUSE = N40°E 73.60'
SE COR HOUSE = N60°E 105.32'
NE COR HOUSE = S62°E 190.40' TO FTDN.
NW IN W SIDE 24" MAP = S60°E 52.58'

APPROVED BY PEER GROUP MAY 1993 AS
PERPETUATION OF ORIGINAL CORNER.

signed by Wayne A. Mostrom Date 2656 00001 1/1993 10-7-93

Surveyor's Michigan License No. 14100

MISC. 7.00