

NOV 15 1994

004 PG 051

FILED

SEP 29 4 53 PM '94

COMMISSION

LAND CORNER RECORDATION CERTIFICATE
Filing Requirement of Act 74, Mich. P.A. 1970Cynthia R. Innatt
REGISTER OF DEEDS
ST. JOSEPH CO MICH

For corners in

ST. JOSEPH

(County)

Located In:

Corner Code: #

PARK TWP.

1. Public Land Survey

T 5 S R 11 W

I-8

2. Property Controlling
in Section

S T R

3. Miscellaneous

S T R

Property in Sec.

S T R

Register of Deeds Stamp & File Number

1. Lot No. , Recorded Plat

2. Private Claims

| | A | B | C | D | E | F | G | H | I | J | K | L | M |
|----|----|----|----|----|----|----|---|---|---|---|---|---|---|
| 2 | 6 | 5 | 4 | 3 | 2 | 1 | | | | | | | |
| 3 | | | | | | | | | | | | | |
| 4 | 7 | 8 | 9 | 10 | 11 | 12 | | | | | | | |
| 5 | | | | | | | | | | | | | |
| 6 | 18 | 17 | 16 | 15 | 14 | 13 | | | | | | | |
| 7 | | | | | | | | | | | | | |
| 8 | 19 | 20 | 21 | 22 | 23 | 24 | | | | | | | |
| 9 | | | | | | | | | | | | | |
| 10 | 30 | 29 | 28 | 27 | 26 | 25 | | | | | | | |
| 11 | | | | | | | | | | | | | |
| 12 | 31 | 32 | 33 | 34 | 35 | 36 | | | | | | | |
| 13 | | | | | | | | | | | | | |

WAYNE A. MOSTROM, in a field survey on SEPTEMBER 9, 1994, hereby certify that under requirements of P.A. 74, Michigan P.A. of 1970, the corner points mentioned in lines 1 and 2 above were in conformance with regulations and rules therefore as required in the current manual of survey instructions of the United States Department of the Interior, Bureau of Land Management or by a decree of a Court of Law and/or that the corner points mentioned in lines 3, 4 and 5 above were in conformance with the rules of the Michigan Board of Land Surveyors or by a Decree of a Court of Law; established, re-established, monumented, re-monumented, recovered, found as expressed below:

NOTE: Not more than 4 corners, all in the same town and range, may be recorded on this certificate.

1. Description of original monument and accessories and/or subsequent restoration:

-8

1976 L.C.R.C.-L-3, P-26

1981 & 1985 SURVEYS BY MOSTROM

LO

PIPE IN MON. BOX

FD. 3/4" PIPE IN MON. BOX

11" W.O. = N59°W 53 LKS

10" HICK. = WEST 41'

1991 L.C.R.C. IN L-3, P-195 & 1994 SURVEY

11" B.O. = S70°E 139 LKS

12" W.O. = N69°E 41.9'

10" W.O. = S70°E 40.7'

3/4" PIPE IN MON. BOX

36" OAK = S80°W 35.40'

P.P. = WEST 62.8'

8" OAK = N45°W 50.45'

6" WAL. = N65°W 52.35'

2. Description of corner evidence found and/or method applied in restoring or reestablishing corner:

-8

D. 3/4" X 38" PIPE DRIVEN BETWEEN TWO OLD STONES IN MON. BOX

6" OAK = S80°W 35.4'

P.P. = WEST 62.8'

0" OAK = N45°W 50.45'

11" WAL. = N65°W 52.35'

COR. IS IN C OF ASPHALT RDWY

AND IN LINE WITH FENCE REMAINS

TO THE WEST

RATIFIED BY PEER GROUP
IN ACCORDANCE WITH P.A. 345
ON Sept. 12th, 1994
CO. REPRESENTATIVE

3. Description of monument for corner and accessories established to perpetuate locating the position of the corner:

-8 (1/4 COR. BETWEEN SEC'S 22 & 23)

ET 5/8" X 24" IRON BAR W/STD. CAP BETWEEN TWO OLD STONES IN MON. BOX

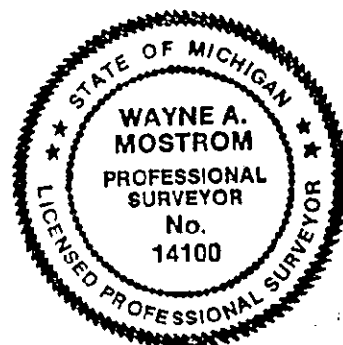
6" OAK = S80°W 35.40'

P.P. = WEST 62.80'

0" OAK = N45°W 50.45'

11" WAL. = N65°W 52.35'

COR. C OF ASPHALT RDWY & IN LINE WITH FENCE TO WEST

Signed by Wayne A. Mostrom
Surveyor's Michigan License No. 14100

Date 9/14/94