

LAND CORNER RECORDATION CERTIFICATE  
Filing Requirement of Act 74, Mich. P.A. 1970

For corners in Nottawa Township

St. Joseph County Located In: Corner Code #  
(County)

1. Public Land Survey T 6S R 10W D-3  
T R  
T R  
T R  
2. Property Controlling S T R SURVEY &  
in Section S T R REMONUMENTATION  
3. Miscellaneous S T R  
Property in Sec. S T R JAN 31 2001

SECTION

4. Lot No. , Recorded Plat  
5. Private Claims

I, David W. Mostrom, in a field survey on August 9, 20 00, do state that under requirements of P.A. 74, Michigan P.A. of 1970, the corner points mentioned in lines 1 and 2 above were in conformance with regulations and rules therefore as required in the current manual of survey instructions of the United States Department of the Interior, Bureau of Land Management or by a decree of a Court of Law and/or that the corner points mentioned in lines 3, 4 and 5 above were in conformance with the rules of the Michigan Board of Land Surveyors or by a Decree of a Court of Law, established, re-established, monumented, recovered, found as expressed below:

NOTE: Not more than 2 corners, all in the same town and range, may be recorded on this certificate.

(D-3) 1/4 CORNER COMMON TO SECTIONS 5 & 8, NOTTAWA TOWNSHIP

A. Description of original monument and accessories and/or subsequent restoration:

GLO 1961 ROAD COMMISSION  
18" Y. OAK = S51°E 35.64'  
10" Y. OAK = N21°E 37.62'  
\*LARGE STONE IN MONUMENT BOX  
\*R.R. RAIL ANCHOR POST = NORTH 29.78'  
\*21" B. OAK = N28°E 28.75'  
\*32" HICKORY = SOUTH 30.65'  
1875 SURVEY IN BOOK A, PAGE 470  
10" HICKORY = N02 1/2°W 39.6'  
8" W. OAK = S65°W 50.82'  
1983 SAYERS SURVEY  
\*STONE IN MON. BOX  
\*R.R. RAIL = NORTH 30.3'  
\*24" OAK = SOUTH 22.2'  
\*24" OAK = N20°E 28.6'  
1991 LCRC IN BOOK 3, PAGE 198  
\*FOUND STONE IN MONUMENT BOX  
\*CENTERLINE ROAD = NORTH 4'  
\*R.R. RAIL ANCHOR POST = NORTH 29.78'  
\*36" HICKORY = SOUTH 30.65'  
\*36" OAK = SOUTH 23'  
\*36" OAK = N28°E 28'

B. Description of corner evidence found and/or method applied in restoring or reestablishing corner:

FOUND STONE IN MONUMENT BOX 1.3' DEEP IN PROJECTION OF FENCELINE TO THE NORTH  
CENTERLINE EAST-WEST GRAVEL ROAD = NORTH 4'  
40" HICKORY = SOUTH 30.36' (30.65')  
R.R. RAIL ANCHOR POST = NORTH 29.78'  
46" OAK = N28°E 28.00'  
36" OAK = SOUTH 23.00'  
SET 5/8" X 6" IRON BAR WITH STANDARD CAP IN CONCRETE OVER STONE IN MONUMENT BOX

C. Description of monument for corner and accessories established to perpetuate locating the position of the corner:

5/8" X 6" IRON BAR WITH STANDARD CAP IN CONCRETE OVER STONE IN MONUMENT BOX  
N & W 2.0' HIGH ON W. SIDE OF 40" HICKORY = SOUTH 30.36'  
N & W 2.0' HIGH ON W. SIDE OF 46" OAK = N28°E 28.00'  
N & W 2.0' HIGH ON W. SIDE OF 36" OAK = SOUTH 23.00'  
R.R. RAIL POST (2.0' HIGH ON NW SIDE) = NORTH 29.78'  
CAPPED IRON = SOUTH 33.00'

Signed by David W. Mostrom  
Surveyor's Michigan License No. 32339

Date August 15, 2000

RATIFIED BY PEER GROUP  
IN ACCORDANCE WITH P.A. 345  
ON Aug. 14, 2000  
CO. REPRESENTATIVE


LIBER 6 PAGE 68  
STATE OF MICHIGAN  
ST. JOSEPH COUNTY  
FILED

18 AUG 2000 10:33:33 AM

CYNTHIA L. JARRATT  
REGISTER OF DEEDS

Register of Deeds Stamp & File Number

	A	B	C	D	E	F	G	H	I	J	K	L	M
1													
2	6			5		4			3		2		1
3													
4	7			8		9			10		11		12
5													
6	18			17		16			15		14		13
7													
8	19			20		21			22		23		24
9													
10	30			29		28			27		26		25
11													
12	31			32		33			34		35		36
13													

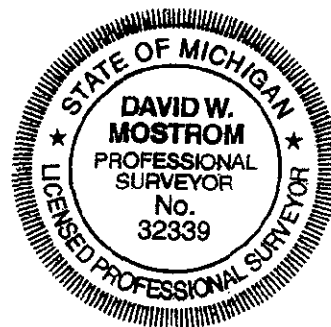

REMONUMENTATION