

SECTION

LAND CORNER RECORDATION CERTIFICATE

Filing Requirement of Act 74, Mich. P.A. 1970

For corners in Lockport Twp.

<u>St. Joseph</u>	Located In:	Corner Code #
(County)		
1. Public Land Survey	T 6SR 11W	E-6
	T R	
	T R	
	T R	
2. Property Controlling in Section	S T R	
	S T R	
3. Miscellaneous Property in Sec.	S T R	
	S T R	

LIBER 6 PAGE 7

STATE OF MICHIGAN
ST. JOSEPH COUNTY
FILED

7 JAN 2000 9:47:32 AM

CYNTHIA L. JARRATT
REGISTER OF DEEDS

Register of Deeds Stamp & File Number

4. Lot No. _____, Recorded Plat _____

5. Private Claims _____

I, Wayne A. Mostrom, in a field survey on 8/3, 1999 do hereby state that under requirements of P.A. 74, Michigan P.A. of 1970, the corner points mentioned in lines 1 and 2 above were in conformance with regulations and rules therefore as required in the current manual of survey instructions of the United States Department of the Interior, Bureau of Land Management or by a decree of a Court of Law and/or that the corner points mentioned in lines 3, 4 and 5 above were in conformance with the rules of the Michigan Board of Land Surveyors or by a Decree of a Court of Law; established, re-established, monumented, recovered, found as expressed below:

NOTE: Not more than 2 corners, all in the same town and range, may be recorded on this certificate.

	A	B	C	D	E	F	G	H	I	J	K	L	M
1													
2	6			5		4		3		2		1	
3													
4	7			8		9		10		11		12	
5													
6	18			17		16		15		14		13	
7													
8	19			20		21		22		23		24	
9													
10	30			29		28		27		26		25	
11													
12	31			32		33		34		35		36	
13													

A. Description of original monument and accessories and/or subsequent restoration:

1903 Survey In
Book 1, page 74
Stake & stone
"Old Corner"
(Stone in Mon. box
was used on multiple
recent surveys)

Road Comm. - 1960's
Triangle stone & box
32" Cherry - N20°E 59.65'
18" Wal. - S3°W 24.9'

Corner checks into
"Ash Subdivision #3"
& Sayers 1964 Survey
#5053

1974 LCRC in L-1, p-121

Pipe found in Mon. box
30" Tree - NE 58.85'
P.P. - South 41.38'

Mostrom 1995 Survey

Pointed sto. in Mon. box
P.P. - S64°W 82.22'
10" Tree - S72°W 59.55'
P.P. - N84°E 87.32'
Cor. is 1.5' N. of Road C


B. Description of corner evidence found and/or method applied in restoring or reestablishing corner:

Found $\frac{1}{2}$ " x 6" bar over large brown stone
in Mon. box (triangular)
Cor. is in proj. of fence to South & 2' N. of C rdwy
All witnesses to 1995 Survey check O.K.
P.P. = South 41.38'

RATIFIED BY PEER GROUP
IN ACCORDANCE WITH P.A. 345
ON AUG. 9, 1999
Wayne A. Mostrom CO. REPRESENTATIVE

C. Description of monument for corner and accessories established to perpetuate locating the position of the corner:

Set 5/8" x 8" bar w/std. cap in conc. in Mon. box over stone
N & W in W. side P.P. = South 41.38'
N & W in NW side P.P. = S60°W 82.22'
N & W in N. side P.P. = N80°W 114.63'
N & W in N. side Tele. pole = N80°E 87.37'
NW cor. hse. = S57°E 99.10'

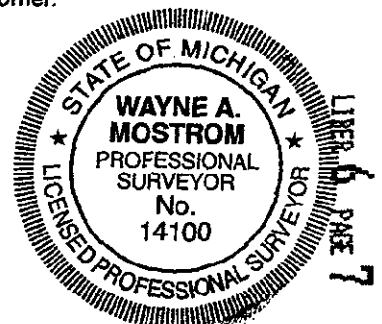

Signed by Wayne A. Mostrom
Surveyor's Michigan License No. 14100

Date December 30, 1999

REMONUMENTATION