

LAND CORNER RECORDATION CERTIFICATE
Filing Requirement of Act 74, Mich. P.A. 1970

For corners in

<u>St. Joseph</u> (County)	Located In:	Corner Code //
1. Public Land Survey	T 7S R 12W	D3
	T 7S R 12W	E3
	T R	
	T R	
2. Property Controlling in Section	S T R	
	S T R	
3. Miscellaneous Property in Sec.	S T R	
	S T R	

Register of Deeds Stamp & File Number

4. Lot No. _____, Recorded Plat _____
 5. Private Claims _____

I, Gary C. Bilow, in a field survey on E3 April 06, 1992, 19_____, do hereby certify that under requirements of P.A. 74, Michigan P.A. of 1970, the corner points mentioned in lines 1 and 2 above were in conformance with regulations and rules therefore as required in the current manual of survey instructions of the United States Department of the Interior, Bureau of Land Management or by a decree of a Court of Law and/or that the corner points mentioned in lines 3, 4 and 5 above were in conformance with the rules of the Michigan Board of Land Surveyors or by a Decree of a Court of Law, established, re-established, monumented, re-monumented, recovered, found as expressed below:

NOTE: Not more than 4 corners, all in the same town and range, may be recorded on this certificate.

A	B	C	D	E	F	G	H	I	J	K	L	M
2	6	5	4	3	2	1						
3												
4	7	8	9	10	11	12						
5												
6	18	17	16	15	14	13						
7												
8	19	20	21	22	23	24						
9												
10	30	29	28	27	26	25						
11												
12	31	32	33	34	35	36						
13												

A. Description of original monument and accessories and/or subsequent restoration:


D3: Post established by U.S. Deputy Surveyor C. Britain in 1828 - accessories: Tamarack 4", N80E 51; Tamarack 7", S27E 1.23. D. Scott in January 1960 reset corner midway on line between Southeast and Southwest section corners as a 1" pipe with brass cap - accessories: 8" & 23" Ash, N71E 72.7'; 30' West of Stream thread; 30' to Stream from Southeast.
 E3: Post established by U.S. Deputy Surveyor C. Britain in 1828 - accessories: White Oak 26", S71E 71; White Oak 5", S47-1/2W 1.76. County Surveyor Todd in 1888 in County Survey Records makes an illegible reference to this corner on pages 562 to 564. In January 1960 Department of Conservation Surveyor D. Scott records in field notes: Witnesses to iron - 14" Aspen, S24E 37.29'; 16" Oak, S7W 29.11; 12" Oak, S68W 69.59'.

B. Description of corner evidence found and/or method applied in restoring or reestablishing corner:

D3: Found 1" pipe with brass cap 0.14' East and 1.54' North of midpoint and recovered one of Scott's accessories. Accepted corner as the best evidence of the original GLO post.
 E3: Found Department of Conservation Monument with brass cap and all of Scott's witnesses. Accepted this corner as the best evidence of the original GLO post.

C. Description of monument for corner and accessories established to perpetuate locating the position of the corner:

D3: Found 1" pipe with brass cap	E3: Department of Conservation Monument
S69E 44.08', N&T West face 10" Pine	S71W 69.51', N&T South face 8" White
N63E 72.43', N&T North face 8"-23"	Oak
Maple	S7W 29.19', N&T East face 26" White
N16W 84.61', N&T East face 8" Pine	Oak
N36W 103.31', N&T East face 8" Pine	S60E 11.22', N&T West face 6" Aspen
S35W 42.8', Centerline Creek	N53E 18.94', N&T South face 9" White
N84W 72.5', Centerline bend of Creek	Oak
	North 10', edge of swampy area

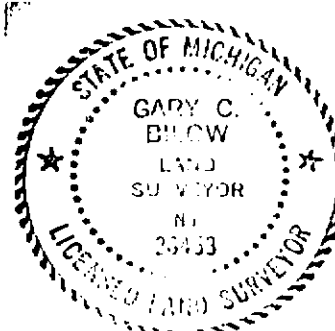

Signed by Gary C. Bilow Date 1/10/92