

SURVEY &
REMONUMENTATION

JAN 22 1999

SECTION

LAND CORNER RECORDATION CERTIFICATE
Filing Requirement of Act 74, Mich. P.A. 1971

For Corners in

ST. JOSEPH CO. _____ (County)	Located In:	Corner Code #
1. Public Land Survey	T <u>7S</u> R <u>9W</u>	<u>I-2</u>
	T _____ R _____	_____
	T _____ R _____	_____
	T _____ R _____	_____
2. Property Controlling	S _____ T _____ R _____	_____
in Section	S _____ T _____ R _____	_____
3. Miscellaneous	S _____ T _____ R _____	_____
Property in Sec.	S _____ T _____ R _____	_____
4. Lot No. _____, Recorded Plat _____		
5. Private Claims _____		

LIBER 5 PAGE 108

STATE OF MICHIGAN
ST. JOSEPH COUNTY
FILED

15 DEC 1998 11:12:40 AM

CYNTHIA L. JARRATT
REGISTER OF DEEDS

Register of Deeds Stamp & Filing Number

I, DONALD C. ANDREWS, in a field survey on JUNE 2, 1998, do hereby certify that under requirements of P.A. 74, Michigan P.A. of 1970, the corner points mentioned in lines 1 and 2 above were in conformance with regulations and rules therefor as required in the current manual of survey instructions of the United States Department of the Interior, Bureau of Land Management or by a decree of a Court of Law and/or that the corners mentioned in lines 3, 4 and 5 above were in conformance with the rules of the Michigan Board of Land Surveyors or by a Decree of a Court of Law; established, re-established, monument, re-monumented, recovered, found as expressed below:

NOTE: Not more than 2 corners, all in the same town and range, may be Recorded on this certificate.

A. Description of original monument and accessories and/or Subsequent restoration:

GLO POST BEARING TREES GONE

1867 CO. SURVEYOR'S RECORDS BOOK A, P. 158 STONE
FROM ORIGINAL BEARINGS STUMPS

May 1962 CO. ROAD COM. RECORDS "X" STONE IN BOX

MOSTROM 1985 FOUND PIPE IN MON BOX AND SURVEY IN 1997
FOUND PIPE IN BOX

Nov 1995 LCRC 4, P 202 ANDREWS FOUND 1/2" PIPE IN MON BOX
WITH WIT. ALL WIT CHECK WITH LCRC

B. Description of corner evidence found and/or method applied in restoring or reestablishing corner:


FOUND 1/2" x 2.3' PIPE IN BOX. REMOVED BOX AND FOUND STONE BELOW PIPE. NOTE: STONE 2 FEET 10 INCHES BELOW
SURFACE OF ROAD. DISTANCES TO WITNESSES IN LCRC 4, P. 202 CHECK GOOD AND ARE SHOWN IN PART "C" BELOW.

C. Description of monument for corner and accessories to perpetuate locating the position of the corner:

SET 5/8" IRON X 24 INCHES WITH STANDARD REMON. CAP OVER STONE IN MON. BOX

18" HICKORY WEST 57.40'
60" WILLOW S 65°W 63.66'
AP N 85°W 35.46'
30" TRIPLE OAK N 55°E 72.40'

RATIFIED BY PEER GROUP
IN ACCORDANCE WITH P.A. 345
ON JUNE 8, 1998
DONALD C. ANDREWS
CO. REPRESENTATIVE

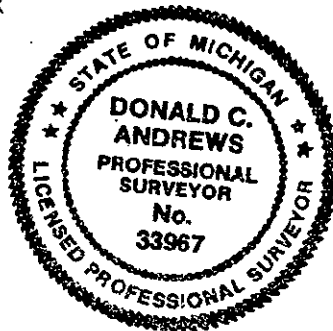

Signed by Donald C. Andrews Date 10/28/98

Surveyors Michigan License No. 33967

FORM APPROVED BY MICHIGAN STATE BOARD OF LAND SURVORS, JAN. 28, 1971

REVISED MAY 14, 1975

REVISED JAN., 1983

REVISED OCT., 1995

ADAPTED FOR WORD PROCESSING

REMONUMENTATION

LIBER 5 PAGE 108