

SURVEY &
REMONUMENTATION
APR 10 1995
COMMISSION

LAND CORNER RECORDATION CERTIFICATE
Filing Requirement of Act 74, Mich. P.A. 1970

LIBER 4 PAGE 79

For corner
St. Joseph
(County)

Located In:

Corner Code #

1. Public Land Survey T 8 S R 9 W B-1
T R
T R
T R
T R
2. Property Controlling S T R
in Section S T R
3. Miscellaneous S T R
Property in Sec. S T R

STATE OF MICHIGAN
ST. JOSEPH COUNTY
FILED

20 DEC 94 12:36 P.M.

CYNTHIA JARRATT
REGISTER OF DEEDS
Register of Deeds Stamp & File Number

4. Lot No. , Recorded Plat
5. Private Claims

I, Donald C. Andrews, in a field survey on November, 19 94, do hereby certify that under requirements of P.A. 74, Michigan P.A. of 1970, the corner points mentioned in lines 1 and 2 above were in conformance with regulations and rules therefore as required in the current manual of survey instructions of the United States Department of the Interior, Bureau of Land Management or by a decree of a Court of Law and/or that the corner points mentioned in lines 3, 4 and 5 above were in conformance with the rules of the Michigan Board of Land Surveyors or by a Decree of a Court of Law; established, re-established, monumented, re-monumented, recovered, found as expressed below:

NOTE: Not more than 4 corners, all in the same town and range, may be recorded on this certificate.

A. Description of original monument and accessories and/or subsequent restoration:

1825 GLO Post, Co. Surv. Rec. A, P 496 Todd, Post from original bearings trees
record dist from N1/4 to NW corner is 2789.82' (2789.30'M)
Co. Rd. stone under box
Mostrom survey 1992 pipe/box

	A	B	C	D	E	F	G	H	I	J	K	L	M
2	6		5		4		3		2		1		
3													
4	7		8		9		10		11		12		
5													
6	18		17		16		15		14		13		
7													
8	19		20		21		22		23		24		
9													
10	30		29		28		27		26		25		
11													
12	31		32		33		34		35		36		
13													

B. Description of corner evidence found and/or method applied in restoring or reestablishing corner:


found 1/2" pipe over stone in box

RATIFIED BY PEER GROUP
IN ACCORDANCE WITH P.A. 345
ON SEPT 12, 1994
Alan CO. REPRESENTATIVE

C. Description of monument for corner and accessories established to perpetuate locating the position of the corner:

reset 1/2" pipe with Remon. capped iron over stone in box

- 1) power pole S40°W 37.95'
- 2) 30"-40" quint oak N5°W 51.45'
- 3) 1/2" iron N30°W 38.00'
- 4) 1/2" pipe S30°E 34.71'

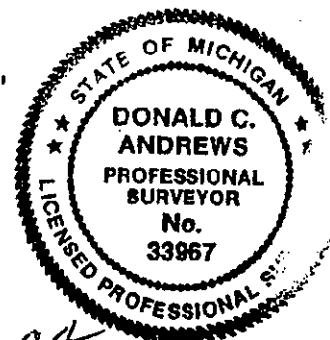

Signed by Donald C. Andrews Date 12-12-94

Surveyor's Michigan License No. 33967

REMONUMENTATION

LIBER 4 PAGE 79