

SURVEY & REMONUMENTATION
LAND CORNER RECORDATION CERTIFICATE
Filing Requirement of Act 74, Mich. P.A. 1970

For corners in St. Joseph
(County)

APR 10 1995
located in:

Corner Code ##

LIBER **4** PAGE **82**

STATE OF MICHIGAN
ST. JOSEPH COUNTY
FILED

20 DEC 94 12:37 P.M.

CYNTHIA JARRATT
REGISTER OF DEEDS
Register of Deeds Stamp & File Number

1. Public Land Survey 8S R 9W B-2
T R
T R
T R
2. Property Controlling S T R
in Section S T R
3. Miscellaneous S T R
Property in Sec. S T R

4. Lot No. , Recorded Plat
5. Private Claims

I, Donald C. Andrews, in a field survey on November, 19 94, do hereby certify that under requirements of P.A. 74, Michigan P.A. of 1970, the corner points mentioned in lines 1 and 2 above were in conformance with regulations and rules therefore as required in the current manual of survey instructions of the United States Department of the Interior, Bureau of Land Management or by a decree of a Court of Law and/or that the corner points mentioned in lines 3, 4 and 5 above were in conformance with the rules of the Michigan Board of Land Surveyors or by a Decree of a Court of Law; established, re-established, monumented, re-monumented, recovered, found as expressed below:

NOTE: Not more than 4 corners, all in the same town and range, may be recorded on this certificate.

	A	B	C	D	E	F	G	H	I	J	K	L	M
2				5		4		3		2		1	
3													
4	7		8		9		10		11		12		
5													
6	18		17		16		15		14		13		
7													
8	19		20		21		22		23		24		
9													
10	30		29		28		27		26		25		
11													
12	31		32		33		34		35		36		
13													

A. Description of original monument and accessories and/or subsequent restoration:

no original corner established.

Plat of Lakeview Manor shows location of center of Section 6, subsequent surveys followed which used the center as shown on the plat. The corner as monumented was found to be not at the intersection of the North-South 1/4 line and the East-West 1/4 line. The Remonumentation Peer Group after reviewing the evidence determined that the corner as monumented is the one that should be used as the correct Center of Section 6.

B. Description of corner evidence found and/or method applied in restoring or reestablishing corner:

The Remonumentation Peer Group after reviewing the evidence, determined that the corner as monumented is the one that should be used as the correct Center of Section 6.


The center corner was found monumented with a 1/2" iron over a 3/4" pinch pipe 1' below the ground.

RATIFIED BY PEER GROUP
IN ACCORDANCE WITH P.A. 348
JON SEPT. 12, 1994
 CO. REPRESENTATIVE

C. Description of monument for corner and accessories established to perpetuate locating the position of the corner:

Reset Remon. capped iron in place of the found iron and pipe.

- 1) utility pole S45°W 8.04'
- 2) NE corner of RR rail S10°E 10.26'
- 3) 18" Locust S45°E 10.88'
- 4) 18" locust East 14.41'

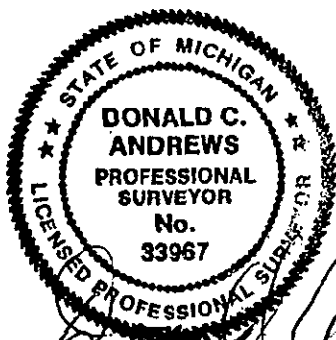

Signed by Donald C. Andrews

Date 12-12-94

Surveyor's Michigan License No. 33967

REMONUMENTATION