

SECTION

LAND CORNER RECORDATION CERTIFICATE  
Filing Requirement of Act 74, Mich. P.A. 1971

For Corners in

St. Joseph  
(County)  
1. Public Land Survey Located In: Corner Code #  
T 8S R 9W K-2  
T R  
T R  
T R  
2. Property Controlling S T R  
in Section S T R  
3. Miscellaneous S T R  
Property in Sec. S T R  
4. Lot No. Recorded Plat  
5. Private Claims

LIBER 5 PAGE 234  
STATE OF MICHIGAN  
ST. JOSEPH COUNTY  
FILED

22 DEC 1999 11:01:40 AM

CYNTHIA L. JARRATT  
REGISTER OF DEEDS

Register of Deeds Stamp & Filing Number

I, Donald C. Andrews, in a field survey on November, 1999, do hereby certify that under requirements of P.A. 74, Michigan P.A. of 1970, the corner points mentioned in lines 1 and 2 above were in conformance with regulations and rules therefor as required in the current manual of survey instructions of the United States Department of the Interior, Bureau of Land Management or by a decree of a Court of Law and/or that the corners mentioned in lines 3, 4 and 5 above were in conformance with the rules of the Michigan Board of Land Surveyors or by a Decree of a Court of Law; established, re-established, monument, re-monumented, recovered, found as expressed below:

NOTE: Not more than 2 corners, all in the same town and range, may be Recorded on this certificate.

A. Description of original monument and accessories and/or Subsequent restoration:

LCRC 5, PAGE 156

B. Description of corner evidence found and/or method applied in restoring or reestablishing corner:

Found Remon Capped Iron not inside Mon Box as recorded.

The St. Joseph County Land Corners being located were done within specifications for Order "C 2-II". The closest the National Geodetic Reference System monument having a position order of "B" incorporated in the traverse network was the monument having the PID of "AA8117" with Station Name of "IRS-F". The maximum positional error of each Land Corner monument being located would be less than 0.08 feet relative to the connecting HARN control monuments of the National Geodetic Reference System based on a 95% confidence level.


C: Description of monument for corner and accessories to perpetuate locating the position of the corner:

Found Remon Capped Iron

It's coordinates in international feet are: Northing 112066.2823, Easting 12865739.1452

Witness: 10" AP North 28.35', RR Tie Post S10°W 13.35', UP N82°E 108.56', UP N4°E 174.04'

RATIFIED BY PEER GROUP  
IN ACCORDANCE WITH P.A. 345  
ON APRIL 19, 1999  
Wm. CO. REPRESENTATIVE  
12/21/99 Wm

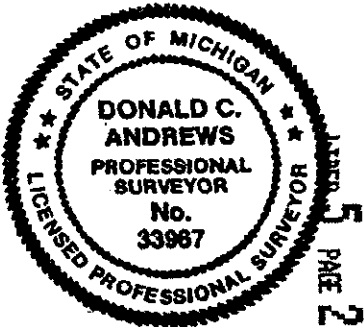

Signed by Donald Andrews Date 12-20-99

Surveyors Michigan License No. 33987

FORM APPROVED BY MICHIGAN STATE BOARD OF LAND SURVYORS, JAN. 28, 1971  
REVISED MAY 14, 1976  
REVISED JAN., 1983  
REVISED OCT., 1986  
ADAPTED FOR WORD PROCESSING

REMONUMENTATION