

SCHOOLCRAFT COUNTY
PEER GROUP APPROVED

DATE 11/8/99 JAB

LAND CORNER RECORDATION CERTIFICATE
Filing Requirement of Act 74, Mich. P.A. 1970

JAN 25 2000

SECTION

For corners in

Schoolcraft

(County)

Located In:

Corner Code #

1. Public Land Survey

T41N R15W

M3

T41N R14W

A3

T R

T R

T R

2. Property Controlling
in Section

S

T R

S

T R

3. Miscellaneous

S

T R

Property in Sec.

S

T R

SIGRID HEDBERG

SCHOOLCRAFT CO. REGISTER

1P

Page 1 of 1

LC 4/292

JLO Date 12/22/1999

Time 13:49:49

RECORDING FEES:

9.00

Register of Deeds Stamp & File Number

4. Lot No. , Recorded Plat

5. Private Claims

I, Thomas P. O'Brien, in a field survey on Dec. 20, 1999 do hereby state that under requirements of P.A. 74, Michigan P.A. of 1970, the corner points mentioned in lines 1 and 2 above were in conformance with regulations and rules therefore as required in the current manual of survey instructions of the United States Department of the Interior, Bureau of Land Management or by a decree of a Court of Law and/or that the corner points mentioned in lines 3, 4 and 5 above were in conformance with the rules of the Michigan Board of Land Surveyors or by a Decree of a Court of Law; established, re-established, monumented, recovered, found as expressed below:

NOTE: Not more than 2 corners, all in the same town and range, may be recorded on this certificate.

A. Description of original monument and accessories and/or subsequent restoration:

August 6, 1845 J. Burt, DS set post corner of Sections 1 and 12
Cedar 19 N8W 21 Hemlock 10 S45W 33

May 15, 1980 Robert E. Schmeling, RLS reestablished corner from Soo Line Railroad survey map information.

B. Description of corner evidence found and/or method applied in restoring or reestablishing corner:

Dec. 20, 1999 Thomas P. O'Brien, PS recovered 1" pipe at corner location. Existing witnesses verify corner position. Reset 1" pipe w/Schoolcraft County monument stamped to identify.

C. Description of monument for corner and accessories established to perpetuate locating the position of the corner:

Schoolcraft County monument

Witnesses:


8" Cedar S30°E 3.1 to centerline tree

10" Cedar S75°W 10.7' to centerline tree

10" Cedar N30°W 23.4' to centerline tree

7" Cedar N45°E 5.0' to centerline tree

Carsonite Post North 1.0'

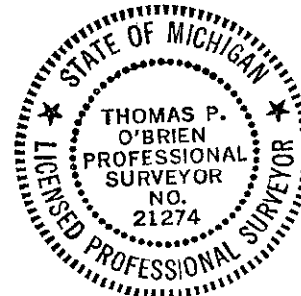

Signed by Thomas P. O'Brien

Date Dec. 22, 1999

Surveyor's Michigan License No. 21274