

SCHOOLCRAFT COUNTY
PEER GROUP APPROVED
DATE 10/10/00 JPB

SURVEY &
REMONUMENTATION

FEB 08 2001

LAND CORNER RECORDATION CERTIFICATE
Filing Requirement of Act 74, Mich. P.A. 1970

SECTION

For corners in

Schoolcraft Located in: Corner Code #
(County)
1. Public Land Survey T 42N R 14W I12
T R
T R
T R
2. Property Controlling S T R
in Section S T R
3. Miscellaneous S T R
Property in Sec. S T R

SIGRID HEDBERG 1P
SCHOOLCRAFT CO. REGISTER
Page 1 of 1 LC 4/388
JL0 Date 12/19/2000 Time 11:53:29

Register of Deeds Stamp & File Number

4. Lot No. , Recorded Plat
5. Private Claims

I, Thomas P. O'Brien, in a field survey on 10/30/00 x10x do hereby state that under requirements of P.A. 74, Michigan P.A. of 1970, the corner points mentioned in lines 1 and 2 above were in conformance with regulations and rules therefore as required in the current manual of survey instructions of the United States Department of the Interior, Bureau of Land Management or by a decree of a Court of Law and/or that the corner points mentioned in lines 3, 4 and 5 above were in conformance with the rules of the Michigan Board of Land Surveyors or by a Decree of a Court of Law; established, re-established, monumented, recovered, found as expressed below:

NOTE: Not more than 2 corners, all in the same town and range, may be recorded on this certificate.

	A	B	C	D	E	F	G	H	I	J	K	L	M
1													
2	6		5		4		3		2		1		
3													
4	7		8		9		10		11		12		
5													
6	18		17		16		15		14		13		
7													
8	19		20		21		22		23		24		
9													
10	30		29		28		27		26		25		
11													
12	31		32		33		34		35		36		
13													

A. Description of original monument and accessories and/or subsequent restoration:

April 1, 1851 Algernon Merryweather, DS set $\frac{1}{4}$ post Cedar 5 in N22W 10 links
Cedar 5 in S60E 8 links

Feb.22, 1982 Gary E. Koepke, PS "found monument box under bituminous surface with $\frac{3}{4}$ " iron pin 1.2 ft. below surface of E'ly side of box, 5.8 ft. North of U.S.2 exsisting centerline and concrete R.O.W. markers North and South of monument box. Set 2 rings on monument box to bring to highway surface. $\frac{1}{2}$ " copper clad rod over $\frac{3}{4}$ " iron pin.

B. Description of corner evidence found and/or method applied in restoring or reestablishing corner:

Oct.30, 2000 Thomas P. O'Brien, PS found $\frac{1}{2}$ " copper rod with 26458 cap in monument box 5.8' North of centerline U.S.2.

C. Description of monument for corner and accessories established to perpetuate locating the position of the corner:

$\frac{1}{2}$ " copper rod with 26458 cap in monument box.

Witnesses:

12" Cedar S30°W 93.10'

10" Cedar S33°E 101.25'

R/w Marker S7°W 86.10'

R/W Marker N6°E 114.25'


12" Cedar N42°E 87.2'

Carsonite P0st N6°E 55.0'

Signed by Thomas P. O'Brien

Surveyor's Michigan License No. 21274

Date Dec.12, 2000

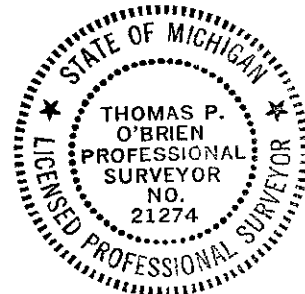

LIBER 4 PAGE: 388