


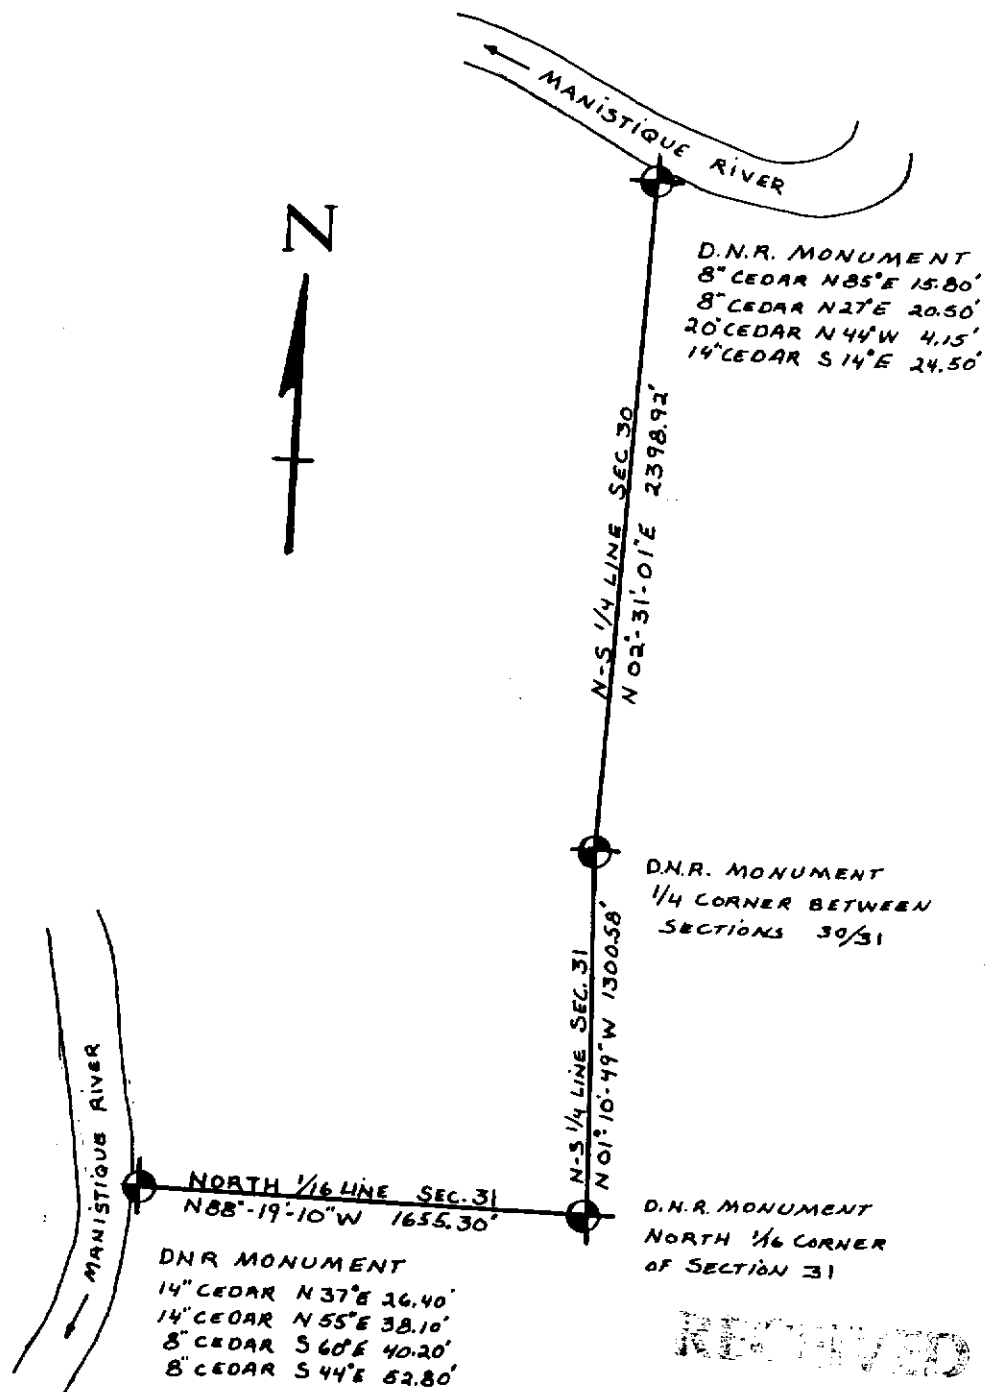

RECEIVED

APR 7 1999

RECEIVED BY THE
 DEPT. OF NATURAL RESOURCES