

SCHOOLCRAFT COUNTY
PEER GROUP APPROVED

DATE Dec. 7, 1995

LAND CORNER RECORDATION CERTIFICATE
Filing Requirement of Act 74, Mich. P.A. 1970

JAN 30 1996

COMMISSION

For corners in

Schoolcraft
(County)

Located In:

Corner Code #

1. Public Land Survey T 42N R 15W D11
T _____ R _____
T _____ R _____
T _____ R _____
2. Property Controlling S _____ J _____ R _____
in Section S _____ T _____ R _____
3. Miscellaneous S _____ T _____ R _____
Property in Sec. S _____ T _____ R _____

4. Lot No. _____, Recorded Plat _____
5. Private Claims _____

Received & Filed this 26 day of
Dec. 1995 at 2:34 PM

Sigrid I. Hedberg
Schoolcraft Co. Reg. of Deeds

Register of Deeds Stamp & File Number

I, Thomas P.O'Brien, in a field survey on Oct. 2, 1995,
do hereby certify that under requirements of P.A. 74, Michigan P.A. of 1970, the corner points mentioned
in lines 1 and 2 above were in conformance with regulations and rules therefore as required in the
current manual of survey instructions of the United States Department of the Interior, Bureau of Land
Management or by a decree of a Court of Law and/or that the corner points mentioned in lines 3, 4 and 5
above were in conformance with the rules of the Michigan Board of Land Surveyors or by a Decree of a
Court of Law; established, re-established, monumented, re-monumented, recovered, found as
expressed below:

NOTE: Not more than 4 corners, all in the same town and range, may be recorded
on this certificate.

A. Description of original monument and accessories and/or subsequent restoration:

D11 ($\frac{1}{4}$ Corner common to Sections 29 and 32)
Sept. 19, 1850 Algernon Merryweather D.S. set gr. section post.
Cedar 6 in. S41W 32 links Cedar 8" S16E 15"

B. Description of corner evidence found and/or method applied in restoring or reestablishing corner:

D11 May 21, 1984 Thomas P.O'Brien, RLS established corner by single
proportionment measurement between C11 and E11. Recorded corner in Liber
2 page 5, Schoolcraft County Register of Deeds.

Oct. 4, 1995 Thomas P.O'Brien, PS recovered Schoolcraft County monument
set May 21, 1984.

C. Description of monument for corner and accessories established to perpetuate locating the position of the corner:

D11 Schoolcraft County monument stamped to identify.


Witnesses:

8" Cedar N65°E 46.10'
12" Cedar S47°E 65.70' (Existing witness in good condition)
12" White Birch N74°E 39.60' (Existing witness in poor condition)
10" Cedar N15°W 56.67'
5" Balsam S86°W 15.85'
Cedar Post North 1.5'

Signed by Thomas P. O'Brien

Date Dec. 20, 1995

Surveyor's Michigan License No. 21274

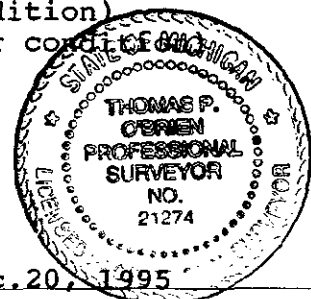

LIBER 4 PAGE: 22