

SURVEY &
REMONUMENTATION

NOV 21 1996

RECEIVED

SCHOOLCRAFT COUNTY
PEER GROUP APPROVED

LAND CORNER RECORDATION CERTIFICATE

DATE 7/12/96

Filing Requirement of Act 74, Mich. P.A. 1970

For corners in

Schoolcraft
(County)

Located In:

Corner Code #

Received & Filed this 8th day of
October 19 96 at 11:31 AM

Sigrid I. Hedberg
Schoolcraft Co. Reg. of Deeds

1. Public Land Survey T 42 N R 15 W G-11
T R
T R
T R
2. Property Controlling S T R
in Section S T R
3. Miscellaneous S T R
Property in Sec. S T R

Register of Deeds Stamp & File Number

4. Lot No. , Recorded Plat
5. Private Claims

Thomas P. O'Brien in a field survey on August 14, 19 96, do hereby certify that under requirements of P.A. 74, Michigan P.A. of 1970, the corner points mentioned in lines 1 and 2 above were in conformance with regulations and rules therefore as required in the current manual of survey instructions of the United States Department of the Interior, Bureau of Land Management or by a decree of a Court of Law and/or that the corner points mentioned in lines 3, 4 and 5 above were in conformance with the rules of the Michigan Board of Land Surveyors or by a Decree of a Court of Law; established, re-established, monumented, re-monumented, recovered, found as expressed below:

NOTE: Not more than 4 corners, all in the same town and range, may be recorded on this certificate.

	A	B	C	D	E	F	G	H	I	J	K	L	M
2	6		5		4		3		2		1		
3													
4	7		8		9		10		11		12		
5													
6	18		17		16		15		14		13		
7													
8	19		20		21		22		23		24		
9													
10	30		29		28		27		26		25		
11													
12	31		32		33		34		35		36		
13													

A. Description of original monument and accessories and/or subsequent restoration:

G-11 (Section Corner common to sections 27, 28, 33 and 34)
Sept. 18, 1850 Algernon Merryweather D.S. set corner post
Beech 10 in. N49W 37 links Hemlock 8" S32E 26 "

B. Description of corner evidence found and/or method applied in restoring or reestablishing corner:

G-11 June, 1977 Beryl M. Jones, R.L.S. found 3/4" iron, with no witnesses.
June 30, 1983 Donald R. Schofield, R.L.S. recovered 3/4" iron, L1, Pg. 229.
August 14, 1996 Thomas P. O'Brien, P.S. recovered 3/4" iron and reset with Schoolcraft County Monument.

SURVEY &
REMONUMENTATION

DEC 16 1996

COMMISSION

C. Description of monument for corner and accessories established to perpetuate locating the position of the corner:


G-11 Set Schoolcraft County Monument stamped to identify.

Witnesses: Made X in NE curb corner - N50°E - 79.70'
Fd. 20" Spruce - S77°E - 62.25' (M) Ex. Cond.
Fd. 12" Spruce - S71°W - 59.37' (M) Ex. Cond.
Fd. Power Pole - N37°W - 196.42' (M)
C/L Co.Rd. 433 - North - 25.20'
Set 4" Cedar Post South 10.0'

Signed by Thomas P. O'Brien

Date August 14, 1996

Surveyor's Michigan License No. 21274

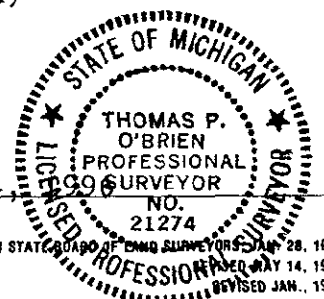

FORM APPROVED BY MICHIGAN STATE BOARD OF LAND SURVEYORS JAN. 28, 1971
REVISED MAY 14, 1975
REVISED JAN., 1983