

SCHOOLCRAFT COUNTY
PEER GROUP APPROVED
DATE 12/10/96

SURVEY &
REMONUMENTATION
MAY 16 1997
COMMISSION

LAND CORNER RECORDATION CERTIFICATE
Filing Requirement of Act 74, Mich. P.A. 1970

For corners in

Schoolcraft (County)	Located In:	Corner Code #
1. Public Land Survey	T42NR15W	I-9
	T R	
	T R	
	T R	
2. Property Controlling in Section	S T R	
	S T R	
3. Miscellaneous Property in Sec.	S T R	
	S T R	

Received & Filed this 30 day of
Dec. 1996 at 9:34 AM
Sigrid I. Hedberg
Schoolcraft Co. Reg. of Deeds

Register of Deeds Stamp & File Number

4. Lot No. _____, Recorded Plat _____
5. Private Claims _____

Thomas P. O'Brien in a field survey on Dec. 12, 1996 do hereby state that under requirements of P.A. 74, Michigan P.A. of 1970, the corner points mentioned in lines 1 and 2 above were in conformance with regulations and rules therefore as required in the current manual of survey instructions of the United States Department of the Interior, Bureau of Land Management or by a decree of a Court of Law and/or that the corner points mentioned in lines 3, 4 and 5 above were in conformance with the rules of the Michigan Board of Land Surveyors or by a Decree of a Court of Law, established, re-established, monumented, recovered, found as expressed below:

NOTE: Not more than 2 corners, all in the same town and range, may be recorded on this certificate.

	A	B	C	D	E	F	G	H	I	J	K	L	M
1													
2	6		5		4		3		2		1		
3													
4	7		8		9		10		11		12		
5													
6	18		17		16		15		14		13		
7													
8	19		20		21		22		23		24		
9													
10	30		29		28		27		26		25		
11													
12	31		32		33		34		35		36		
13													

A. Description of original monument and accessories and/or subsequent restoration:


I-9 (Section Corner common to sections 22, 23, 26 & 27.)
Sept. 13, 1850 - Algernon Merryweather D.S. set corner post.
Balsam 6 in. S67E 9 links Elm 7" N38W 13 "
June 30, 1983 - Donald R. Schofield set 3/8" reinforcing bar 18" with cap.

B. Description of corner evidence found and/or method applied in restoring or reestablishing corner:

I-9 Dec. 12, 1996 - Thomas P. O'Brien, P.S. recovered 18" pipe w/cap # 25871 as set by Donald R. Schofield, and reset corner with Schoolcraft County monument. Corner has been used in surveys of record.

C. Description of monument for corner and accessories established to perpetuate locating the position of the corner:

I-9 Schoolcraft County monument stamped to identify.
Witnesses: 6" Maple - N12°E - 60.08'
8" Cedar - S8°E - 66.03'
Corner fence post - N88°W - 14.59'
Fence post - N41°W - 19.97'
4" Cedar post - North - 2.0'

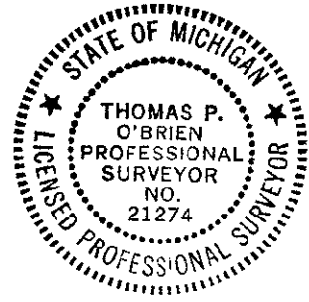

Signed by Thomas P. O'Brien Date Dec. 12, 1996
Surveyor's Michigan License No. 21274