

SCHOOLCRAFT COUNTY
PEER GROUP APPROVED
DATE 12/10/96

SURVEY &
REMONUMENTATION

LAND CORNER RECORDATION CERTIFICATE
Filing Requirement of Act 74, Mich. P.A. 1970

MAY 16 1997

For corners in

Schoolcraft
(County)

Located In:

Corner Code #

1. Public Land Survey

T42NR15W
T42NR16W

A-12
M-12

2. Property Controlling
in Section

S

T R

3. Miscellaneous
Property in Sec.

S

T R

S

T R

S

T R

4. Lot No. _____, Recorded Plat _____

5. Private Claims _____

COMMISSION
Received & Filed this 30 day of
Dec 1996 at 9:33 AM
Sigrid I. Hedberg
Schoolcraft Co. Reg. of Deeds

Register of Deeds Stamp & File Number

	A	B	C	D	E	F	G	H	I	J	K	L	M
1													
2	6		5		4		3		2		1		
3													
4	7		8		9		10		11		12		
5													
6	18		17		16		15		14		13		
7													
8	19		20		21		22		23		24		
9													
10	30		29		28		27		26		25		
11													
12	31		32		33		34		35		36		
13													

I, Thomas P. O'Brien in a field survey on Oct. 25, 1996 do hereby state that under requirements of P.A. 74, Michigan P.A. of 1970, the corner points mentioned in lines 1 and 2 above were in conformance with regulations and rules therefore as required in the current manual of survey instructions of the United States Department of the Interior, Bureau of Land Management or by a decree of a Court of Law and/or that the corner points mentioned in lines 3, 4 and 5 above were in conformance with the rules of the Michigan Board of Land Surveyors or by a Decree of a Court of Law; established, re-established, monumented, recovered, found as expressed below:

NOTE: Not more than 2 corners, all in the same town and range, may be recorded on this certificate.

A. Description of original monument and accessories and/or subsequent restoration:

A-12 Aug. 3, 1845 - John Burt D.S. set qr. section post.
W. Birch 5 N86W 21 links do. 5 S44W 27 "

March 14 & 15, 1988 - Gerald L. Wiggins L.S. set corner " midpoint
on line between N.E. Corner and S.E. Corner of section."


B. Description of corner evidence found and/or method applied in restoring or reestablishing corner:

A-12 Oct. 25, 1996 - Thomas P. O'Brien, P.S. recovered corner as set by
Gerald L. Wiggins. Corner distances check well for single
proportionate measurement.

C. Description of monument for corner and accessories established to perpetuate locating the position of the corner:

A-12 D.N.R. monument found.

Witnesses: Fd. 8" Cedar - West - 20.95'
Fd. 10" Cedar - N51°W - 29.00'
NBT. 6" Cedar - N28°E - 16.90'
Fd. 6" Cedar - S39°E - 18.05'

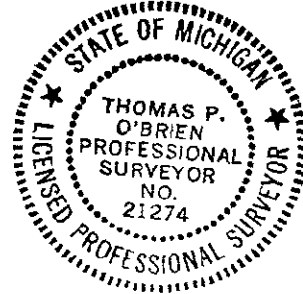

Signed by Thomas P. O'Brien

Surveyor's Michigan License No. 21274

Date Dec. 26, 1996

LIBER 4 PAGE: 105