

LAND CORNER RECORDATION CERTIFICATE
Filing Requirement of Act 74, Mich. P.A. 1970

For corners in

Schoolcraft

(County)

Located in:

Corner Code #

1. Public Land Survey

T 43N R 16W

G12

T R

T R

T R

2. Property Controlling
in Section

S 33

T 43N R 16W

2

S T R

3. Miscellaneous
Property in Sec.

S

T R

S T R

Register of Deeds Stamp & File Number

4. Lot No. , Recorded Plat

5. Private Claims

2 Aug 18 2004

G12 Aug 10 2004

I, Stephan J. Szyszkoski, in a field survey on _____, 19____ do hereby state that under requirements of P.A. 74, Michigan P.A. of 1970, the corner points mentioned in lines 1 and 2 above were in conformance with regulations and rules therefore as required in the current manual of survey instructions of the United States Department of the Interior, Bureau of Land Management or by a decree of a Court of Law and /or that the corner points mentioned in lines 3, 4 and 5 above were in conformance with the rules of the Michigan Board of Land Surveyors or by a Decree of a Court of Law; established, re-established, monumented, recovered, found as expressed below:

NOTE: Not more than 2 corners, all in the same town and range, may be recorded on this certificate.

	A	B	C	D	E	F	G	H	I	J	K	L	M
1													
2	6		5			4		3		2		1	
3													
4	7		8			9		10		11		12	
5													
6	18		17			16		15		14		13	
7													
8	19		20			21		22		23		24	
9													
10	30		29			28		27		26		25	
11													
12	31		32			33		34		35		36	
13													

A. Description of original monument and accessories and/or subsequent restoration:

(G12) Quarter corner common to Sections 33 and 34. 1850 - Established by A.Merryweather: [south] Corrected bet. Sec. 33 & 34 ...40.00 1/4 post. Spruce 5" S35W 5 links, Spruce 4" N75E 7 links. ...80.00 Section corner.
(2-Sec. 33) East 1/16 corner between Sections 28-33. Not established in the original survey.

B. Description of corner evidence found and/or method applied in restoring or reestablishing corner:

(G12) The original post and accessories were not recovered. Reestablished the corner by single proportionate measurement to the original record between Section corners 2644.50' north and south.
(2-Sec. 33) Established the corner midway and on the Section line between Quarter corner 1327.36' west and Section corner 1327.36' east.

C. Description of monument for corner and accessories established to perpetuate locating the position of the corner:

(G12) Set 1"IDx36" I.pipe with 4" alum.

MDNR cap. Blazed, scribed, and set

measuring nails in:

6" Spruce N73W 18.95' "1/4S N8T"

6" Spruce S43W 15.9' do

4" Spruce S06E 2.0' do

5" Spruce N14W 7.0' do

Set a cedar post adjacent. Bearings are

magnetic. Distances are to nail with

tag.

(2) Set 1"IDx36" I.pipe with 4" alum.

MDNR cap. Blazed, scribed, and set

measuring nails in:

6" Cedar S68E 7.1' "E1/16 8T"


12" Cedar S19E 13.45' do

12" Tamarack S76W 24.8' do

5" Cedar N33W 7.05' do

Bearings are magnetic. Distances are to

nail with tag.

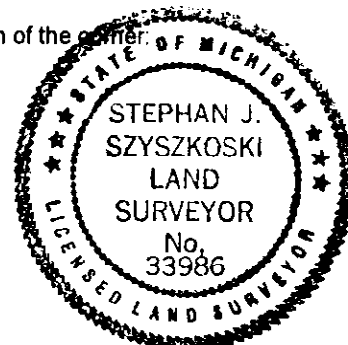

Signed by Stephan J. Szyszkoski

Date 9/14/04

Surveyor's Michigan License No. 33986