

MICHIGAN  
DEPARTMENT OF CONSERVATION  
FORESTRY DIVISION

# LAND CORNER RECORD

T. 45 N.R. 15-16W


Schoolcraft COUNTY

DESCRIPTION OF CORNER 1/4 corner between Sec. 31 and 36

CORNER MONUMENT 1" I.D. iron pipe, length unknown, coupling threaded on upper end.

DATE MONUMENT PLACED AND WITNESSED Date placed unknown, rewitnessed 9/14/64

WITNESSES TO CORNER..... Red Maple 6 N13W 15 1/2 links, "1/4S, NBT"

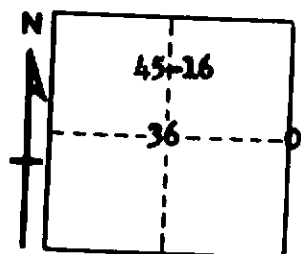

do 8 S3W 31 " "1/4S, NBT"

White Spruce 7 N82E 17 1/2 " "1/4S, NBT"

AND

CIRCLE CORNER REGISTERED

DESCRIPTION IN DETAIL AS TO HOW CORNER WAS LOCATED AND IDENTIFIED OR RESTORED.

Corner located in 1963 by W. J. Wallace and A. O. Eger. Pipe in place, set by unknown surveyor about 25 years ago, and witnessed as follows: White Spruce 12 N74W 21 links and White Spruce 12 S66E 31 links. The latter has a single large face at base of tree which is scribed, from top to bottom, "BT, 1/4, 31". The former appears to have been similarly marked, but blaze is covered with overgrowth.

There is a rotted hemlock stump, identifiable by bark, bearing N30W 10 links from the pipe, presumably an original BT as given in original field notes. Distances north and south to stream crossings are in good agreement with position of the pipe, although the stream bed has shifted somewhat since the original survey was made.

SURVEYOR'S SEAL

SIGNED

Arthur O. Eger  
REGISTERED LAND SURVEYOR  
Arthur O. Eger  
RLS 13581

DATE

9-17-64