

SURVEY & REMONUMENTATION

MAY 28 1997

COMMISSION

REMONUMENTATION

LAND CORNER RECORDATION CERTIFICATE

Filing Requirement of Act 74, Mich. P.A. 1970

RECORDED

96 AUG 16 PM 2:38

REGISTER OF DEEDS

Gayle Schubert
SHIAWASSEE COUNTY, MICH.

For corners in

Shiawassee
(County)

Located In:

Corner Code #

1. Public Land Survey

T 7N R 1E

D-08 (W 1/4 20)

2. Property Controlling
in Section

S T R

3. Miscellaneous
Property in Sec.

S T R

4. Lot No. Recorded Plat

5. Private Claims

Register of Deeds Stamp & File Number

I, Norman C. Caldwell, in a field survey on April 1996, do hereby certify that under requirements of P.A. 74, Michigan P.A. of 1970, the corner points mentioned in lines 1 and 2 above were in conformance with regulations and rules therefore as required in the current manual of survey instructions of the United States Department of the Interior, Bureau of Land Management or by a decree of a Court of Law and/or that the corner points mentioned in lines 3, 4 and 5 above were in conformance with the rules of the Michigan Board of Land Surveyors or by a Decree of a Court of Law; established, re-established, monumented, re-monumented, recovered, found as expressed below:

NOTE: Not more than 4 corners, all in the same town and range, may be recorded on this certificate.

A. Description of original monument and accessories and/or subsequent restoration:

D-08 Closing West 1/4 Corner of Section 20, T 7 N, R 1 E.

This position not marked by the original government survey.

There is no record of any subsequent monumentation of this position.

B. Description of corner evidence found and/or method applied in restoring or reestablishing corner:

D-08 Closing West 1/4 Corner of Section 20, T 7 N, R 1 E.

Following an extensive search, it was determined there is no evidence of monumentation at this position.

A standard Harrison monument was placed on the Michigan Meridian at the midpoint between closing Section Corners and in line with an ancient fence North/South.

Approved by the joint Clintron/Shiawassee County Remonumentation peer group 22 May 1996.

C. Description of monument for corner and accessories established to perpetuate locating the position of the corner:

D-08 Closing West 1/4 Corner of Section 20, T 7 N, R 1 E.

Placed a standard Harrison monument on the Michigan Meridian at the midpoint between Closing Section Corners of Section 20.

References:


N 50 W 13.45' 12018 tag in 12" Ash
N 05 W 22.50' 12018 tag in 14" Ash
S 50 E 4.20' 12018 tag in 6" Basswood
S 75 E 23.66' 12018 tag 8" Twin Ash

APPROVED
5/22/96 MLCV
County Remonumentation
Peer Review Group

Signed by

Date 31 MAY 1996

Surveyor's Michigan License No. 12018

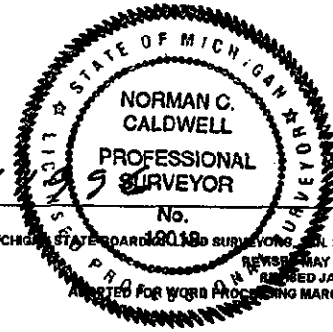

LIBER 1R PG 157