

SURVEY & REMONUMENTATION

NOV 03 1998

SECTION

1998 REMONUMENTATION PROGRAM
LAND CORNER RECORDATION CERTIFICATE
Filing Requirement of Act 74, Mich. P.A. 1970

For corners in

Shiawassee
(County)

Located In: Hazelton Twp

Corner Code #



3007730
Page: 1 of 2
10/27/1998 03:22P
Lb-1 Pg-283

1. Public Land Survey T 8 N R 4 E M-9
T R
T R
T R
2. Property Controlling S T R
in Section S T R
3. Miscellaneous S T R
Property in Sec. S T R

Register of Deeds Stamp & File Number

4. Lot No. , Recorded Plat
5. Private Claims

I, John H. Rauser, P.S., in a field survey on February 9, 19 98 do hereby certify that under requirements of P.A. 74, Michigan P.A. of 1970, the corner points mentioned in lines 1 and 2 above were in conformance with regulations and rules therefore as required in the current manual of survey instructions of the United States Department of the Interior, Bureau of Land Management or by a decree of a Court of Law and/or that the corner points mentioned in lines 3, 4 and 5 above were in conformance with the rules of the Michigan Board of Land Surveyors or by a Decree of a Court of Law; established, re-established, monumented, re-monumented, recovered, found as expressed below:

NOTE: Not more than 2 corners, all in the same town and range, may be recorded on this certificate.

	A	B	C	D	E	F	G	H	I	J	K	L	M
1													
2	6	5	4	3	2	1							
3													
4	7	8	9	10	11	12							
5													
6	18	17	16	15	14	13							
7													
8	19	20	21	22	23	24							
9													
10	30	29	28	27	26	25							
11													
12	31	32	33	34	35	36							
13													

A. Description of original monument and accessories and/or subsequent restoration:
M - 9 Standard Corner, Sections 24 & 25, T8N-R4E, Hazelton Township

- 1822 Wood post placed by Joseph Wampler D.S.: Beech 8 S68W, 24 links
Beech 9 N21E, 05.5 links
1876 Survey by Lyman Mason, C.S. referenced post, Elm 14 N28 1/2W 189 links, Measured 39.48 ch. between M-9 and L-9, measured 39.775 ch. between M-9 and M-10.
1898 Survey by E. F. Joslin, C.S., Elm 14 N28 1/2W 189 links

Continued on back :


B. Description of corner evidence found and/or method applied in restoring or reestablishing corner:
M - 9 Standard Corner, Sections 24 & 25, T8N-R4E, Hazelton Township

Found hole in asphalt (previous PK Nail), and 2 accessories from 1987 (Drill hole to E at 1.78', and PK in P/P to NW at 69.99'), and 3 accessories from 1993 (Closing corner A-5, T8N-R5E, to N at 250.72', and Drill hole to E at 2.12', and N&T in T/P to NE at 103.25'). Measured West 2610.63' (39.56 ch.) to L-9 (1822 GLO 39.89 ch., 1876 C.S. rec. 39.48 ch., 1972 rec. 2610.49', 1993 rec. 2610.68'), measured South 2644.88' (39.77 ch.) to M-10 (1822 GLO 40.00 ch., 1876 C.S. 39.775 ch., 1972 rec. 2627.99'), measured North 250.72' (3.80 ch.) to A-9, T-8,R5E (1822 GLO 3.80 ch., 1981 rec. 250.8', 1987 rec. 250.80'). We accept the position of the hole in asphalt as the best available evidence of the position of the original government corner.

C. Description of monument for corner and accessories established to perpetuate locating the position of the corner:
M - 9 Standard Corner, Sections 24 & 25, T8N-R4E, Hazelton Township

Set standard Harrison monument cap welded to a 5/8" X 24" rebar over a 1/2" X 18" rebar driven with a sleeve on the end of the 5/8" rebar and a monument box with flange approximately 4" deep concreted in place at the position approved by the Shiawassee County peer review group.

- N35E 102.94' Found Nail & Tag # 11192 SE Fc P/P
S78E 76.95' Set Nail & Tag # 39096 N Fc 10" Spruce
S17W 167.95' Set Nail & Tag # 39096 E Fc 25" Red Oak
S13W 105.90' E ly Edge M-13 Sign Post
S70W 44.11' W ly Post of Stop Sign
N64W 70.22' Found PK Nail E Fc P/P
N86E 2.12' Found 1/2" Drill Hole
N85E 1.82' Found 1/2" Drill Hole

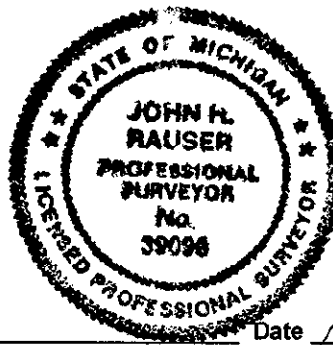

Signed by
Surveyor's Michigan License No. 39096

Date 10/21/98

M-9

A. Continued:

- 1972 CPGCo Un-recorded survey by E J McCombs, P.S. # 10696, F.B. 1270, DWG No S-F17561, Sheet 4, Rev.A; No corner symbol shown, No accessories
Measured 2610.49' (39.55 ch.) between M-9 and L-9, measured 2627.99' (39.81 ch.) between M-9 and M-10.
- 1981 Survey by Mark L. VanRaemdonck, P.S. # 24622, L. 3, P. 493; Set PK Nail.
N60W 71.91' Set PK in Power Pole
S45E 69.43' Set Pk in 8" Maple
S45W 45.39' N leg stop sign
North 250.80' Mon. box
- 1982 Survey by Jan S. Fokens, P.S. # 21567, L.3, P. 602; Found PK Nail.
N60W 71.91' Set PK in Power Pole
S45E 69.43' Set Pk in 8" Maple
S45W 45.39' N leg stop sign
North 250.80' Mon. box
- 1987 Survey by Jack N. Owens, P.S. # 20709, L. 5, P. 106; Set PK Nail & Tag # 11192.
East 1.78' Set 1/2" drill hole
N60W 69.99' Fnd PK SE Fc PP
N61W 69.38' Set rod/cap #20709 @ R/W
S70E 71.12' Set PK N Fc of TP
West 16.58' Set PK on S/L Sec. 24
- 1989 Survey by Mark L. VanRaemdonck, P.S. # 24622, L. 5, P. 354; Set PK Nail.
N60W 70.2' Set PK in P. Pole
S45W 44.00' N leg stop sign
North 250.80' Mon. box
N40E 102.94' Spike in SE Fc utility pole
S20W 87.50' E edge M-13 sign post
- 1993 Survey by Mark L. VanRaemdonck, P.S. # 24622, L. 6, Pgs. 582
ch.) between M-9 and L-9, measured 2610.14' (40.05 ch.) between M-9 and L-9. Mass Tag # 11192. Measured 2610.68' (39.56 ch.) between M-9 and L-9.
North 250.72' Cor. A-9, T8N-R5E, Genesee
N61W 69.38' Set 1/2" rerod & cap #20709
S20W 87.50' E. edge M-13 road sign post
S70E 71.15' Set PK N Fc 12" Ash
East 2.12' 1/2" x 2" deep drill hole, C/L 24' bit pavement
N40E 103.25' Set N & T #11192 SE Fc T. pole
N60W 69.95' Fnd PK SE Fc P. Pole

SURVEY &
REMONUMENTATION

NOV 03 1998

SECTION



Kaye Grubba - Shiawassee Co.

REMON

3007730

Page: 2 of 2

10/27/1998 03:22P

Lb-1 Pg-283