

SURVEY &
REMONUMENTATION

FEB 08 2001

2000 REMONUMENTATION PROGRAM
LAND CORNER RECORDATION CERTIFICATE
Filing Requirement of Act 74, Mich. P.A. 1970

REGISTERED FOR RECORD
LIBER NO. PAGE NO.
#124 Vassar
00 DEC 20 PM 2:45

SECTION

For corners in: VASSAR TOWNSHIP

TUSCOLA
(County)

Located In:

Corner Code #

1. Public Land Survey

T 11N R 08E

M-13

2. Property Controlling
in Section

S T R


3. Miscellaneous
Property in Sec.

S T R

4. Lot No.

Recorded Plat

5. Private Claims

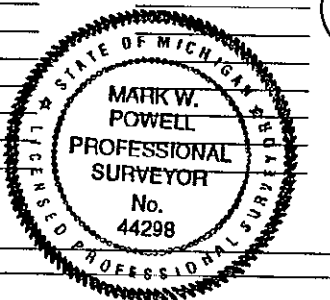

Seg. 2

TUSCOLA COUNTY
REGISTERED DEEDS

Register of Deeds Stamp & File Number

	A	B	C	D	E	F	G	H	I	J	K	L	M
1													
2	6	5	4	3	2	1							
3													
4	7	8	9	10	11	12							
5													
6	18	17	16	15	14	13							
7													
8	19	20	21	22	23	24							
9													
10	30	29	28	27	26	25							
11													
12	31	32	33	34	35	36							
13													

I, MARK W. POWELL, P.S., in a field survey on AUGUST 17, 20 00
do hereby certify that under requirements of P.A. 74, Michigan P.A. of 1970, the corner points mentioned
in lines 1 and 2 above were in conformance with regulations and rules therefore as required in the
current manual of survey instructions of the United States Department of the Interior, Bureau of Land
Management or by a decree of a Court of Law and/or that the corner points mentioned in lines 3, 4 and 5
above were in conformance with the rules of the Michigan Board of Land Surveyors or by a Decree of a
Court of Law; established, re-established, monumented, re-monumented, recovered, found as
expressed below:

NOTE: Not more than 2 corners, all in the same town and range, may be recorded
on this certificate.

A. Description of original monument and accessories and/or subsequent restoration:

1821 GLO; WAMPLER D.S.; SET POST; SPRUCE 8 N03E 2 LKS., SPRUCE 6 N78E 6 LKS.
1993 DUNTON, P.S.#23503; 1993 REMONUMENTATION LCRC PG 78; SET MONUMENT
1996 ROWE ENG.; FIELD, P.S.#37276; SURVEY, L. 699 PG. 671-672; FND. TUSCOLA CO. MONUMENT; S31°W, 35.00'
NAIL W/TAG #11192 IN 12"ASH, S85°W, 31.20' NAIL W/REMON TAG IN 6" ASH, N57°W, 36.74' NAIL W/REMON
TAG IN 10" ASH, N50°W, 59.35' NAIL W/REMON TAG IN 10" OAK

B. Description of corner evidence found and/or method applied in restoring or reestablishing corner:

2000 ROWE; POWELL, PS #44298; FOUND TUSCOLA COUNTY MONUMENT 3' BELOW ASPHALT ROAD SURFACE;
RECOVERED 1 PREVIOUS WITNESS WHICH INDICATES THAT THE FOUND MONUMENT IS IN THE SAME
POSITION AS IN THE 1993 LCRC CITED IN SECTION A. ABOVE.

ACCEPT FOUND TUSCOLA COUNTY MONUMENT AS A CAREFUL AND FAITHFUL PERPETUATION OF THE
POSITION OF THE ORIGINAL CORNER.

THIS CORNER IS COMMON WITH M-1, T10N-R8E

COPY

C. Description of monument for corner and accessories established to perpetuate locating the position of the corner:

M-1 3 RAISED POSITION OF FOUND MONUMENT WITH 4" CONCRETE MONUMENT WITH REMON CAP STAMPED M-1
T10N-R8E AND INSTALLED MONUMENT BOX (CAP STAMPED P.S.#37276)
S85E 63.27' SET T.C. REMON TAG N. FACE 4" OAK
S40E 79.40' SET T.C. REMON TAG SW. FACE 6" ASH
S70W 42.16' SET T.C. REMON TAG S. FACE 8" ASH
N85W 59.14' FOUND T.C. REMON TAG NE. FACE 8" OAK

APPROVED BY TUSCOLA COUNTY
REMONUMENTATION PEER GROUP

12/14/2000

Signed by Mark W Powell

Date 12-18-00

Surveyor's Michigan License No. 44298