

SURVEY & REMONUMENTATION

DEC 02 1993

COMMISSION

1993 REMONUMENTATION PROGRAM LAND CORNER RECORDATION CERTIFICATE Filing Requirement of Act 74, Mich. P.A. 1970 JUNIATA TOWNSHIP

For corners in

TUSCOLA
(County)

Located In:

Corner Code #1

1. Public Land Survey T 12N R 8E M-6
T R
T R
T R
2. Property Controlling S T R
in Section S T R
3. Miscellaneous S T R
Property in Sec. S T R

4. Lot No. , Recorded Plat
5. Private Claims

RECEIVED FOR RECORD
LIBER NO. PAGE NO.
FILING NO. #68
93 OCT 22 PM 2:44
JUNIATA TWP
VIRGINIA H. HOLLAND
TUSCOLA COUNTY
REGISTER OF DEEDS

Register of Deeds Stamp & File Number

I, Kenneth D. Dunton, in a field survey on July 10, 19 93,
do hereby certify that under requirements of P.A. 74, Michigan P.A. of 1970, the corner points mentioned
in lines 1 and 2 above were in conformance with regulations and rules therefore as required in the
current manual of survey instructions of the United States Department of the Interior, Bureau of Land
Management or by a decree of a Court of Law and/or that the corner points mentioned in lines 3, 4 and 5
above were in conformance with the rules of the Michigan Board of Land Surveyors or by a Decree of a
Court of Law; established, re-established, monumented, re-monumented, recovered, found as
expressed below:

**NOTE: Not more than 4 corners, all in the same town and range, may be recorded
on this certificate.**

A. Description of original monument and accessories and/or subsequent restoration:

1821 G.L.O. Notes	Feb. 13, 1892 Geo. B. Felton, County Surveyor
Joseph Wampler, D.S.	Survey of Section 30, T12N-R9E, under remarks says:
Set post for 1/4 sec. cor.	E 1/4 post Sec. 13, T12N-R8E, was identified from
Hemlock 24" S21°E 9.90'	bearing trees & perpetuated by cedar post, glass &
Maple 12" S5°W 0.66'	W. crockery at corner.

Note: Section A. continued on back of form.

B. Description of corner evidence found and/or method applied in restoring or reestablishing corner:

Found and accepted 1 1/4" iron bar 48" long (top 36" 1 1/4" round & bottom 12" flattened).
Found several pieces of white china and clear glass around iron bar. Found "T" iron
per Act 74, Page 22. Dug and found no other evidence below "T" iron.

C. Description of monument for corner and accessories established to perpetuate locating the position of the corner:


Removed 1 1/4" iron bar and set standard monument with 2" brass cap stamped corner M-6,
T12N-R8E.
N87°56'54"W 35.00' set 1/2" x 18" rod & cap #23503 on 1/4 line per survey Liber 578, Page 1255.
S87°56'54"E 35.00' set 1/2" x 18" rod & cap #23503 on extension of 1/4 line.
N20°17'E 94.93' set T.C. Re-mon. tag & spike in SW face p. pole.
S67°51'E 86.10' set T.C. Re-mon. tag & spike above dbl. head nail in N. face of 12" pine.
S45°00'E 5.35' found "T" iron.
N60°24'W 31.45' East end of 12" CSP field tile from West.

Signed by Kenneth D. Dunton Date Oct. 11, 1993

Surveyor's Michigan License No. 23503

APPROVED

FORM APPROVED BY MICHIGAN STATE BOARD OF LAND SURVEYORS, JAN. 26, 1971
REVISED MAY 18, 1975
REVISED JAN., 1983

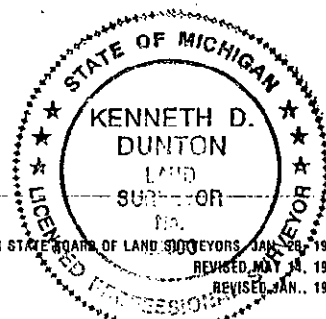

COPY


Continued from Section A. on front of this form:

November 14, 1975 Survey Liber 457, Pages 770, 771 & 772 by James A. Beck, R.L.S. #21559 with Rowe Engineering.
No mention of object found or set. No accessories given. Survey shows $S00^{\circ}07'00''E$ 2603.45' from corner M-6 to corner M-7.

October 5, 1976 Act 74, Juniata Township, 12-8 Page 22 by John W. Martin, R.L.S. #4699.
Found 1 1/4" iron bar 8" below gravel, broken china & glass around iron, 4'± North of & 3.7'± West of T-iron found.
 $N30^{\circ}E$ 94.92' to nail in SW face p. pole.
About 1.0' West of centerline of surface N & S.

December 15, 1987 Survey Liber 578, Pages 1255, 1256 & 1257 by Kenneth D. Dunton, R.L.S. #23503.
Found 1 1/4" iron bar.
 $N75^{\circ}W$ 31.5' East end of 8" C.S.P.
 $N29^{\circ}E$ 95.0' nail in p.p.
South 2607.38' SE corner Section 13.

January 30, 1989 Survey Liber 595, Pages 073 & 074 by Kenneth D. Dunton, R.L.S. #23503.
No mention of object found or set. No accessories given. Bearing and distance of $S01^{\circ}33'15''W$ 2622.25' shown between corners M-5 & M-6.

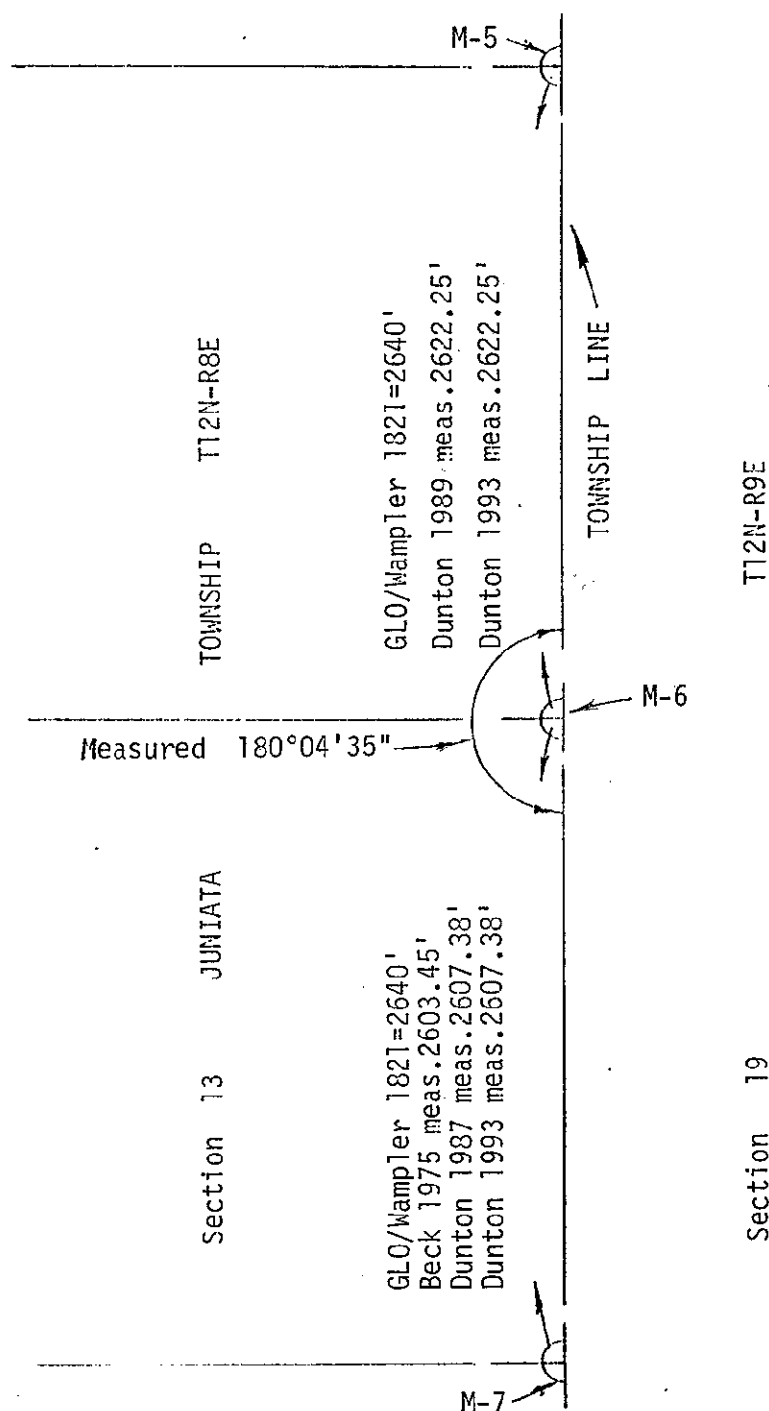

COPY

NORTH
No Scale