

1994 REMONUMENTATION PROGRAM
LAND CORNER RECORDATION CERTIFICATE
Filing Requirement of Act 74, Mich. P.A. 1970

For corners in KINGSTON TOWNSHIP

<u>TUSCOLA</u> (County)	Located In:	Corner Code #
1. Public Land Survey	T 12N. R 11E	M-9
	T _____ R _____	_____
	T _____ R _____	_____
	T _____ R _____	_____
2. Property Controlling in Section	S _____ T _____ R _____	_____
	S _____ T _____ R _____	_____
3. Miscellaneous Property in Sec.	S _____ T _____ R _____	_____
	S _____ T _____ R _____	_____
4. Lot No. _____	Recorded Plat _____	
5. Private Claims _____		

RECEIVED FOR RECORD
LIBER NO. _____ PAGE NO. _____
FILING NO. #53
Kingston Twp
94 NOV -9 PM 2:18
VIRGINIA M. MCLAREN
TUSCOLA COUNTY
REGISTER OF DEEDS

Register of Deeds Stamp & File Number

	A	B	C	D	E	F	G	H	I	J	K	L
2	6	5	4	3	2	1						
3												
4	7	8	9	10	11	12						
5												
6	18	17	16	15	14	13						
7												
8	19	20	21	22	23	24						
9												
10	30	29	28	27	26	25						
11												
12	31	32	33	34	35	36						
13												

I, Lionel Roy Emery, in a field survey on July 11, 1994, do hereby certify that under requirements of P.A. 74, Michigan P.A. of 1970, the corner points mentioned in lines 1 and 2 above were in conformance with regulations and rules therefore as required in the current manual of survey instructions of the United States Department of the Interior, Bureau of Land Management or by a decree of a Court of Law and/or that the corner points mentioned in lines 3, 4 and 5 above were in conformance with the rules of the Michigan Board of Land Surveyors or by a Decree of a Court of Law; established, re-established, monumented, re-monumented, recovered, found as expressed below:

NOTE: Not more than 4 corners, all in the same town and range, may be recorded on this certificate.

A. Description of original monument and accessories and/or subsequent restoration:


- 1834 (Gov't. Land Office Notes) Harvey Parke, D.S.-Set qr. Sec. post- Hemlock 8 S16W 25; Hemlock 6 N18 1/2 W 14
- 1983 (Survey for Ed M. Sowa -Sanilac County) John A. Milletics, P.S. 25859 -shows Northwest Corn of Sec. 30, T12N-R12E - East 68.39' Set Iron Bar; East 93.54' Set Iron Bar (Note: Iron bar set in North Section line as references to Section corner)
- 1992 (Survey for John Powell -Tuscola County, Sec. 25, T12N-R11E) Lionel Roy Emery, P.S. 24593 Found 1/2" Iron bars East of Drain as indicated on Milletics Survey --Found nothing at Sec. Corner-- set 1/2" iron from reference irons, East, 68.39' 1/2" reinforcing rod with cap #25859. East 93.64' 1/2" reinforcing rod with cap #25859; S20°W, 33.03' nail in 14" Elm; N60°W 19.51' nail in 12" Poplar See over for continuation of Section A.

B. Description of corner evidence found and/or method applied in restoring or reestablishing corner:

Found 1/2" reinforcing rod with cap 24593
Accepted reinforcing rod as marking original corner

C. Description of monument for corner and accessories established to perpetuate locating the position of the corner:

Removed reinforcing rod and replaced with Standard Tuscola County Concrete Monument with 2" Brass Cap stamped M9 T12N/R11E
East, 68.39'-Found 1/2" reinforcing rod with cap #25859
East, 93.64'-Found 1/2" reinforcing rod with cap #25859
S20°W, 33.10'-T.C. Re-mon. tag in East face of 16" Elm
N82°W, 12.58'-T.C. Re-mon. tag in North face of post
N60°W, 19.50'-T.C. Re-mon. tag above found nail in East face of 18" Poplar
West, 10.0' -"Survey Marker" witness post

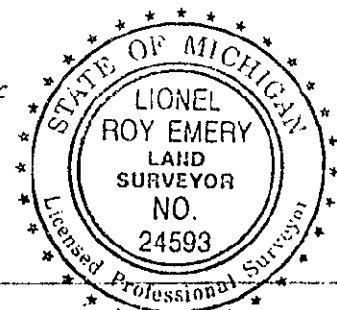

Signed by Lionel Roy Emery Date Oct. 10, 1994
Surveyor's Michigan License No. 24593

APPROVED
10-10-94
[Signatures]

1994 (Land Corner Recordation Certificate) Lionel Roy Emery, P.S. 24593 -Set 1/2" reinforcing rod from reference irons by others- East, 68.39' Found Iron bar w/cap 25859; East, 93.64'-Found Iron bar w/cap 25859; S20°W, 33.03' nail in 14" Elm; N60°W, 19.51'-nail in 12" Poplar

COPY

