

1996 REMONUMENTATION PROGRAM
LAND CORNER RECORDATION CERTIFICATE

Filing Requirement of Act 74, Mich. P.A. 1970

For corners in WISNER TWP.

TUSCOLA

(County)

Located In:

Corner Code #

1. Public Land Survey T 14N R 07E E-13
T _____ R _____
T _____ R _____
T _____ R _____
2. Property Controlling S _____ T _____ R _____
in Section S _____ T _____ R _____
3. Miscellaneous S _____ T _____ R _____
Property in Sec. S _____ T _____ R _____

4. Lot No. _____, Recorded Plat _____
5. Private Claims _____

I, JONATHAN M. FIELD, in a field survey on MAY 21 19 96, do hereby certify that under requirements of P.A. 74, Michigan P.A. of 1970, the corner points mentioned in lines 1 and 2 above were in conformance with regulations and rules therefore as required in the current manual of survey instructions of the United States Department of the Interior, Bureau of Land Management or by a decree of a Court of Law and/or that the corner points mentioned in lines 3, 4 and 5 above were in conformance with the rules of the Michigan Board of Land Surveyors or by a Decree of a Court of Law; established, re-established, monumented, re-monumented, recovered, found as expressed below:

NOTE: Not more than 4 corners, all in the same town and range, may be recorded on this certificate.

- A. Description of original monument and accessories and/or subsequent restoration:
1834 GLO; RISDON, D.S.; SET POST; B. ASH 9 N53W 23LKS, B. ASH 8 N58E 47LKS
1959 WITNESS CARD AT REI; R.J. BLACK; FND 1/2" IRON; S5W 12.92' COR NW HDWALL, S70E 44.25' N COR OF E BR. RAIL
1971 ROWE ENG.; ROWE, P.S.#11192; SURVEY L.1, PG.201; NORTH 10.5' C/L AKRON RD, EAST 20.9' C/L QUANICASSEE RD., S5W 13.04' N COR OF NW WINGWALL
1986 DUNTON, P.S.#23503; SURVEY L.578, PG.26; NO OBJECT STATED; E. 33.37' TO E-1 T13N-R7E
1994 GUTHRIE, P.S.#22435; LCRC PG.23; 1/2" ROD IN MON BOX; S15E NE COR OF BRIDGE ABUTMENT 72.3', N20W NAIL IN UTILITY POLE 59.15', S05E SW COR OF BRIDGE CONC RAILING BLOCK 22.62' SOUTH BOTTOM RAILING BLOCK ON WEST BRIDGE RAIL 59.10', EAST 1/2" IRON IN MON BOX 37.35'


GLO NOTE FOR T13N-R7E INDICATE THAT THIS CORNER IS NOT COMMON WITH E-1 T13N-R7E

- B. Description of corner evidence found and/or method applied in restoring or reestablishing corner:
1996 ROWE ENG.; FIELD, P.S.#37276; FND. 1/2" ROD IN MON. BOX

ACCEPTED ROD IN MON BOX AS BEST EVIDENCE OF ORIGINAL CORNER POSITION

- C. Description of monument for corner and accessories established to perpetuate locating the position of the corner:
E-13 REPLACED 1/2" ROD W/ 5/8" ROD W/STANDARD REMON CAP STAMPED "E 13 T14N R7E" ENCASED IN CONC. IN MON. BOX
S38°E, 72.42' NE CORNER OF CONC. ABUTMENT
S10°E, 22.46' SW CORNER OF CONC. RET. WALL
S03°E, 58.35' NW CORNER OF CONC. RET. WALL
EAST, 37.39' FND. 1/2" ROD IN MON. BOX AT APPARENT E-1 T13N-R7E
N24°W, 59.09' FND. P-K NAIL IN SW FACE P.POLE

Signed by Jonathan M. Field Date 12-24-96
Surveyor's Michigan License No. 37276

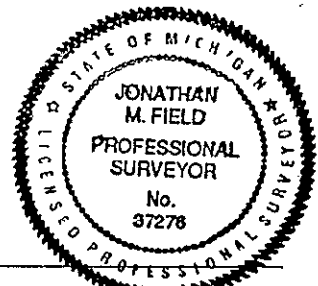

APPROVED
12-23-96

FORM APPROVED BY MICHIGAN STATE BOARD OF LAND SURVEYORS, JAN. 28, 1971
REVISED MAY 14, 1976
REVISED JAN., 1993
ADAPTED FOR WORD PROCESSING MARCH, 1993

REMONUMENTATION

MAY 20 1997

REMONUMENTATION

1-2

